

MADISON

MISSISSIPPI BOARD OF WATER COMMISSIONERS

V 33

1-20-64

WATER WELL DRILLERS LOG

CODED

Date: 1/20

, 1964

Driller:

McKay

(Name)

County

Madison

(1) Owner of Land: Robert Cox

(Name)

Madison

(Address)

(2) Location: 1/4, 1/4, Sec. 1 T 2 R 1 E

6 miles West

(distance)

(direction)

of Madison

(Nearest Town)

(3) Topography:

(Hilly)

(Flat)

(Level)

(4) Purpose of Well: Home

(Domestic Irrigation
Municipal, Industrial, Other)Description & Color of Materials
Sand, Clay, Red Clay, Shell, etc:Thick-
ness
FeetDepth
Feet

Yellow Clay

0

42

Blue Clay

42

84

Blue Clay

84

357

Rock

357

359

Fine Sandy Clay

359

399

Fine Sand

399

492

Fine Sand

492

504

Fine Sand

504

546

Med Sand

546

588

Information upon completion of well:

(1) Diameter 2 inches.

(2) Total Depth 588 feet.

(3) Water Level 122 feet below top of ground.

(4) Cased to , Size

(5) Screen: Size 007, Length 20

(6) Were any formations sealed against pollution?


yes, no.

If YES, depth of formation

Why

Drillers Remarks:

CODED

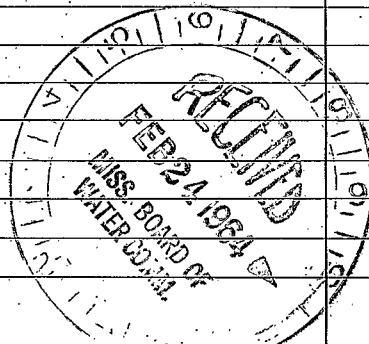

(Use Back Side)

Well No.

Mail this copy to Board of Water Commissioners 429 Miss. St. Jackson, Miss.

