

MADISON MISSISSIPPI BOARD OF WATER COMMISSIONERS

V 34
10-3-64

WATER WELL DRILLERS LOG

CODED

Date: 10/3, 1964, Driller: Forest Drilling, Inc. County: DeWitt
(Name)


(1) Owner of Land: A. L. Pealey
(Name)
Jackson, Miss
(Address)
Madison County
(2) Location: 1/4 Sec. 8 T. 7 R. 12 E.
Livingston Road just
left miles 1 1/2 of Livingston
(Distance) (direction) (Nearest Town)
after taking right
(3) Topography: _____
(Hilly) (Flat) (Level)
(4) Purpose of Well: Farm
(Domestic Irrigation
Municipal, Industrial, Other)

| Description & Color of Materials Sand, Clay, Red Clay, Shell, etc. | Thick- ness Feet | Depth Feet |
|---|------------------------|---------------|
| <u>Brown Clay</u> | | <u>23</u> |
| <u>Blue Clay</u> | | <u>266</u> |
| <u>Blue Shale (Lignite)</u> | | <u>440</u> |
| <u>Fine Shell & Sand</u> | | <u>475</u> |
| <u>Red Lignite & Silt</u> | | <u>546</u> |
| <u>Fine Sand & Shale</u> | | <u>556</u> |
| <u>Fine Sand</u> | | <u>595</u> |
| <u>Rock & Shale</u> | | <u>600</u> |
| <u>Shale & Silt</u> | | <u>614</u> |
| <u>Fine Sand</u> | | <u>633</u> |

Information upon completion of well:

(1) Diameter 2 inches.
(2) Total Depth 633 feet.
(3) Water Level 167 feet below top of ground.
(4) Cased to 213, Size 2"
(5) Screen: Size 2", Length 20ft
(6) Were any formations sealed against pollution?
_____ yes, X no.
If YES depth of formation _____
Why _____
Drillers Remarks: _____

CODED

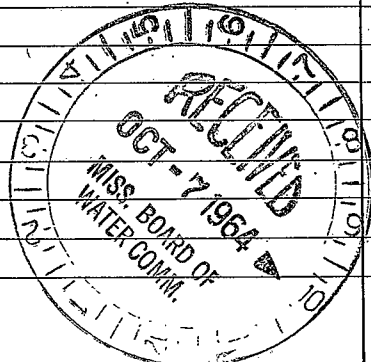

(Use Back Side)

Well No.

