

Log # 222 Not logged to bottom on hole

MADISON

V37 CODED

4-2-72

MISSISSIPPI
BOARD OF WATER COMMISSIONERS
416 North State Street
Jackson, Mississippi 39201

WATER WELL DRILLERS LOG

4-2-72 date well completed

JACK GOMER firm name

MADISON county well located

LANDOWNER LAKE CAUQUE

description of formations encountered

from

to

(mailing address)

WELL LOCATION:

? sec. 8 T. 7 N R. 1 E
S W
5 miles W of JACKSON
(distance) (direction) (nearest town)

WELL PURPOSE:

(home, irrigation, municipal, industrial)

WELL COMPLETION DATA:

- (1) diameter (inches) 4 x 2 1/2
- (2) total depth (feet) 1210
- (3) static water level (feet) 194 below top of ground.
- (4) casing E.C., 1176,
(material) (depth)
4 x 2 1/2 if telescope see back.
(size)
- (5) screen 40', 1176
(length) (depth to top)
2 1/2, SS
(size) (material)
- (6) pump 5, 30
(HP) (yield gpm)
- REA
(type power)
- (7) electric log NO
(yes or no) MCS
(organization running log)
- (8) how well bottom plugged B.W.U.I

TOP SOIL	0	2
YELLOW CLAY	2	35
BLOD CLAY	35	150
SAND	120	160
CLAY	160	330
SAND	330	345
CLAY	345	370
SAND	370	470
CLAY	470	477
SANDY SHALE	477	465
ROCK	465	467
CLAY	467	957
SANDY CLAY	957	1016
SAND	1016	1210


DRILLERS REMARKS:

AUG 23 1972

MISSISSIPPI WATER BOARD

If well telescopes please
sketch and show depths.

GROUND LEVEL

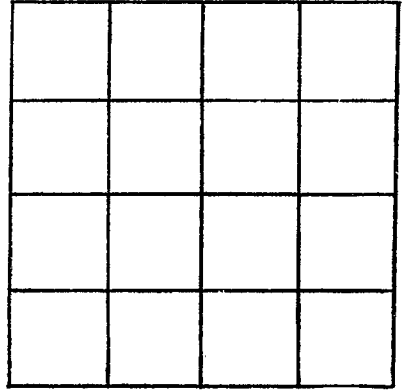

SECTION _____

Please indicate well location X.

ADDITIONAL INFORMATION

If more than one screen,
show locations of each on sketch.