

Madison  
 V45  
 2-2-76  
 Elev #247

MISSISSIPPI  
 BOARD OF WATER COMMISSIONERS  
 416 North State Street  
 Jackson, Mississippi 39201

CODED

WATER WELL DRILLERS LOG

15K  
 Feb. 2, 1976 date well completed  
 E.M. "Bud" Crenshaw firm name  
 Madison county well located

LANDOWNER:  
 William Neal  
 Jackson, Mo.  
 (mailing address)

| description of formations encountered | from | to  |
|---------------------------------------|------|-----|
| Clay                                  | 0    | 460 |
| Hard Shells                           | 460  | 480 |
| Sand                                  | 480  | 560 |

WELL LOCATION:  
 sec. 17 T 7 N R 1 E  
 7 miles N of Jackson  
 (distance) (direction) (nearest town)

WELL PURPOSE: Home  
 (home, irrigation, municipal, industrial)

- WELL COMPLETION DATA:
- (1) diameter (inches) 2
  - (2) total depth (feet) 560
  - (3) static water level (feet) 140 below top of ground.
  - (4) casing Steel 530  
 (material) (depth)
  - 2 if telescope see back.  
 (size)
  - (5) screen 30 530  
 (length) (depth to top)
  - 2 Stainless  
 (size) (material)
  - (6) pump air compressor  
 (HP) (yield gpm)
  - 0  
 (type power)
  - (7) electric log yes  
 (yes or no)  
Stall  
 (organization running log)
  - (8) how well bottom plugged  
steel plug

CODED


RECEIVED

FEB 24 1976

DRILLERS REMARKS:

If well telescopes please sketch and show depths.

GROUND LEVEL

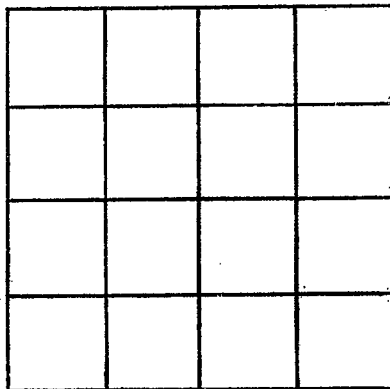

SECTION \_\_\_\_\_

Please indicate well location X.

ADDITIONAL INFORMATION

If more than one screen,  
show locations of each on sketch.