

Madison

Y46

10-23-76

F log #240

10/23

1976

Jack Gunn

Madison

MISSISSIPPI BOARD OF WATER COMMISSIONERS
416 North State Street
Jackson, Mississippi 39201

CODED

WATER WELL DRILLERS LOG

date well completed

firm name

county well located

LANDOWNER: Leon Entekin

Et.

Jackson, Ms.

(mailing address)

description of formations encountered

from

to

YAZOO CLAY

0

460'

SANDY SHALE

460

840

CLAY

840

1000

SAND

1000

1138

WELL LOCATION:

sec. 9 T. 9 N R. 1 E
5 miles N of Jackson
(distance) (direction) (nearest town)

CODED

WELL PURPOSE: Home
(home, irrigation, municipal, industrial)

WELL COMPLETION DATA:

- (1) diameter (inches) 2"
- (2) total depth (feet) 1138
- (3) static water level (feet) 142 below top of ground
- (4) casing Iron, 1060 (material), (depth)
2" (size) if telescope see back.
- (5) screen 20', 1080' (length), (depth to top)
2" (size), Stainless Steel (material)
- (6) pump Air Compressor (HP), (yield gpm)
electricity (type power)
- (7) electric log YES (yes or no)
USGS (organization running log)
- (8) how well bottom plugged


RECEIVED

DEC 9 1976

DRILLERS REMARKS:

If well telescopes please
sketch and show depths.

GROUND LEVEL

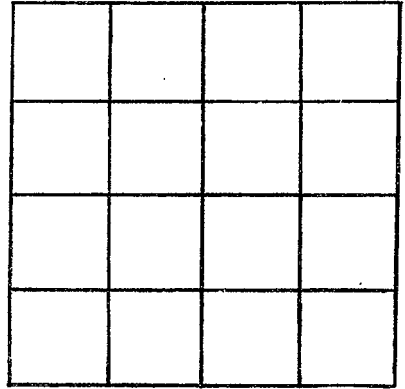

SECTION _____

Please indicate well location X.

ADDITIONAL INFORMATION

If more than one screen,
show locations of each on sketch.