

MADISON  
 V50  
 10/26/79  
 Elog # 256  
 Oct. 26

MISSISSIPPI  
 BOARD OF WATER COMMISSIONERS  
 416 North State Street  
 Jackson, Mississippi 39201

WATER WELL DRILLERS LOG

CODED

19 E.M. "Bud" Cresswell Madison  
 date well completed firm name county well located

LANDOWNER:  
 Browning-Ferris Industries  
 JACKSON, MS.  
 (mailing address)

description of formations encountered	from	to
Clay	0	400
Moody's Blunk	400	430
Hard shells	430	540
Sand	540	615
Chale	615	660

WELL LOCATION:  
 sec 31 T 7 N R 1 E  
 on North Country Line Rd.  
 (distance) (direction) (nearest town)

WELL PURPOSE: Industrial  
 (home, irrigation, municipal, industrial)

- WELL COMPLETION DATA:
- (1) diameter (inches) 4
  - (2) total depth (feet) 660
  - (3) static water level (feet) 240 below top of ground.
  - (4) casing PVC 575 (material) (depth)  
 4 (size) If telescope see back.
  - (5) screen 40 575 (length) (depth to top)  
 2 PVC (size) (material)
  - (6) pump 3 35 (HP) (yield gpm)  
 0 (type power)
  - (7) electric log Yes (yes or no)  
 Ms. State Dept Survey (organization running log)
  - (8) how well bottom plugged  
 Steel plug

CODED

DRILLERS REMARKS:  
 Drilled to 660.  
 Set screen 575 to 615


DEPT. OF NATURAL RESOURCES  
 BUREAU OF LAND & WATER RESOURCES

NOV - 6 1979

RECEIVED

If well telescopes please  
sketch and show depths.

GROUND LEVEL

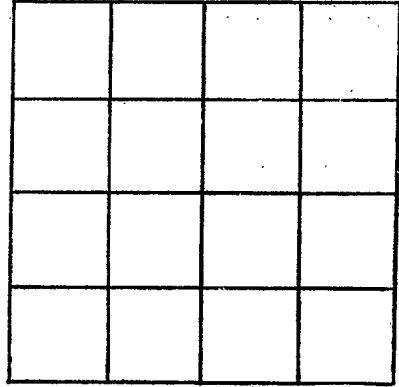

SECTION \_\_\_\_\_

Please indicate well location X.

ADDITIONAL INFORMATION

If more than one screen,  
show locations of each on sketch.