

MADISON
 V 54
 8-12-82

MISSISSIPPI DEPARTMENT OF NATURAL RESOURCES
 Bureau of Land and Water Resources
 Southport Mall
 P.O. Box 10631
 Jackson, Mississippi 39209
 WATER WELL DRILLERS LOG

CODED

Aug. 12 1982 date well completed
 E.M. "Bud" Cresswell firm name
 Madison county well located

LANDOWNER:	description of formations encountered	from	to
William Thompson Madison, Mo. (mailing address)			
WELL LOCATION:			
sec. <u>7</u> T <u>7</u> N R <u>1</u> E			
<u>6</u> miles <u>West</u> of <u>Madison</u>			
(distance) (direction) (nearest town)			
WELL PURPOSE: <u>Home</u> (home, irrigation, municipal, industrial)			
WELL COMPLETION DATA:			
(1) diameter (inches) <u>4</u>			
(2) total depth (feet) <u>630</u>			
(3) static water level (feet) <u>175</u> below top of ground.			
(4) casing <u>Steel</u> , <u>610</u> (material) (depth)			
<u>4</u> (size) if telescope see back.			
(5) screen <u>20</u> , <u>610</u> (length) (depth to top)			
<u>2</u> , <u>Stainless</u> (size) (material)			
(6) pump <u>none</u> (HP) (yield gpm)			
(type power)			
(7) electric log <u>yes</u> (yes or no)			
<u>State</u> (organization running log)			
(8) how well bottom plugged <u>has wash value</u>			
DRILLERS REMARKS:			

CODED


DEPT. OF NATURAL RESOURCES
 BUREAU OF LAND & WATER RESOURCES

AUG 31 1982

RECEIVED

If well telescopes please
sketch and show depths.

GROUND LEVEL

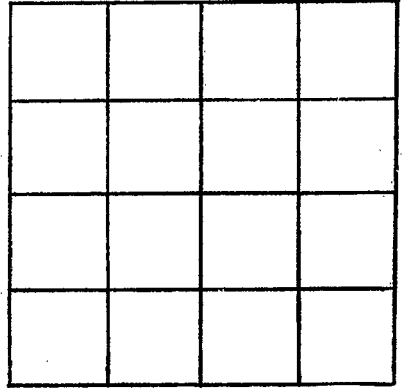

SECTION _____

Please indicate well location X.

ADDITIONAL INFORMATION

If more than one screen,
show locations of each on sketch.