

MISSISSIPPI DEPARTMENT OF NATURAL RESOURCES

Bureau of Land and Water Resources

Southport Mall

P.O. Box 10631

Jackson, Mississippi 39209

WATER WELL DRILLERS LOG

Madison
V 55
5/6/83

May-6-83 1983 E.M. "Bud" CRESSWELL Madison
 date well completed firm name county well located

LANDOWNER:	description of formations encountered	from	to
HENRI P. WATSON JR. JACKSON, MS. (mailing address)			
WELL LOCATION: sec. 17 T-7 N R-1 E AT LAKE CAVALIER (distance) miles (direction) of (nearest town)			
WELL PURPOSE: Home (home, irrigation, municipal, industrial)			
WELL COMPLETION DATA:			
(1) diameter (inches) 4			
(2) total depth (feet) 760			
(3) static water level (feet) 210 below top of ground.			
(4) casing Steel, 730 (material), (depth)			
4 (size) if telescope see back.			
(5) screen 30, 730 (length), (depth to top)			
2, Stainless (size), (material)			
(6) pump 1, 15 (HP), (yield gpm)			
(type power)			
(7) electric log no (yes or no)			
(organization running log)			
(8) how well bottom plugged hard wash valve			

CODED

DEPT. OF NATURAL RESOURCES
BUREAU OF LAND & WATER RESOURCES


JUN - 3 1983

RECEIVED

DRILLERS REMARKS:

If well telescopes please sketch and show depths.

GROUND LEVEL

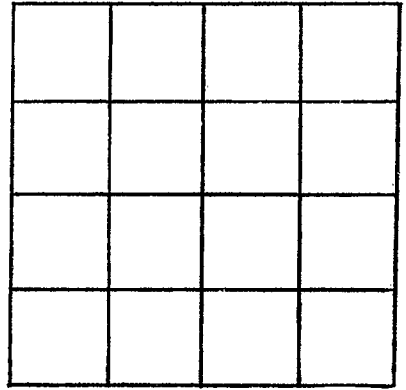

SECTION _____

Please indicate well location X.

ADDITIONAL INFORMATION

If more than one screen,
show locations of each on sketch.