

MISSISSIPPI DEPARTMENT OF NATURAL RESOURCES
Bureau of Land and Water Resources
 Southport Mall
 P.O. Box 10631
 Jackson, Mississippi 39209
WATER WELL DRILLERS LOG

CODED

MADISON
V57
3-15-87

3/15 1987 Ferry Quinn Water Well Ser MADISON
 date well completed firm name county well located

LANDOWNER: Theo Costas
PO Box 1349
Jackson Ms 39215
 (mailing address)

description of formations encountered

	from	to
<u>Clay</u>	<u>0</u>	<u>420</u>
<u>Sand</u>	<u>420</u>	<u>607</u>

CODED

WELL LOCATION:
 sec. 34 T 7 N R 1 E
1/4 miles W of Tougaloo
 (distance) (direction) (nearest town)

WELL PURPOSE: Irrigation
 (home, irrigation, municipal, industrial)

- WELL COMPLETION DATA:**
- diameter (inches) 8x6
 - total depth (feet) 610
 - static water level (feet) 232 below top of ground.
 - casing steel 425'
 (material) (depth)
8" if telescope see back.
 (size)
 - screen 120' 425'
 (length) (depth to top)
6" steel
 (size) (material)
 - pump 30 500
 (HP) (yield gpm)
electricity
 (type power)
 - electric log Yes
 (yes or no)
Ms Geological Survey
 (organization running log)
 - how well bottom plugged Backwash Valve

RECEIVED

JUN 18 1987


Department of Natural Resources
 Bureau of Land & Water Resources

420
120
300
4/15
4

DRILLERS REMARKS:

If well telescopes please sketch and show depths.

GROUND LEVEL

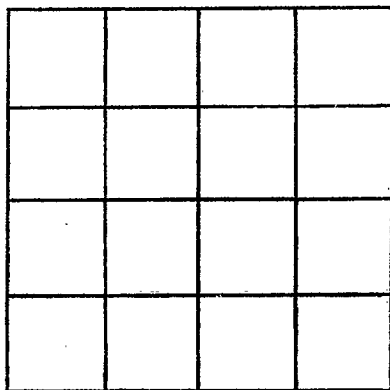

SECTION _____

Please indicate well location X.

ADDITIONAL INFORMATION

If more than one screen, show locations of each on sketch.