

32-26-39  
90-13-03

MISSISSIPPI DEPARTMENT OF NATURAL RESOURCES  
Bureau of Land and Water Resources

229A

COUNTY WELL LOCATED  
Madison

WELL NUMBER V60 CODED

DATE WELL COMPLETED  
Oct. 13, 1989

PERMIT NUMBER

NAME OF DRILLING FIRM  
K.M. Bud Cresswell

BENTONIA, MS.

**CODED**

P.O. Box 10631  
Jackson, Mississippi 39209  
WATER WELL DRILLERS LOG

NAME & MAILING ADDRESS OF LANDOWNER  
Vic Borromeo  
JACKSON, MS.  
217 Society Ridge Rd.  
Madison, MS

WELL LOCATION: SEC 17 TOWNSHIP 87 RANGE 1  
SW/SE 17 87 N 1 E

DISTANCE 2 Miles South DIRECTION of Lake Cavalier NEAREST TOWN

OTHER LANDMARK

WELL PURPOSE:  Home,  Irrigation,  Municipal,  Industrial,  Fish Pond, etc.

PUMP DATA

PUMP TYPE (Circle One):  
 Submersible Turbine, Jet, Flowing Well,  
Other (Describe)

POWER TYPE (Circle One):  
 Electric Tractor, Diesel, Gasoline, Butane,  
Other (Describe) H/P 2

Pump Capacity (GPM) 25 No. of Stages 18 Setting Depth 357 FT.

PUMP TEST

Well yielded 40 GPM with  
a drawdown of 20 ft.  
after 2 hours of pumping

WELL DATA

Well Depth 1200 Casing Diameter (In.) 4 Casing Length (Ft.) 1160

Type of Casing Steel Hole Depth 1200 Depth to Static Water Level 270

TYPE OF COMPLETION: (Circle One or More):  
 Gravel Packed,  Underreamed,  Telescoped,  
 Natural Development,  Open Hole,  Other  
(Describe)

Top of Lap Pipe or Reduction in Casing

FEET IF TELESCOPED OR MORE THAN ONE SCREEN: USE BACK PAGE

LOG DATA

TYPE OF LOG RUN (Circle One):  
Electric, Gamma Ray, Density, Sonic, Neutron,  
Other (Describe)  No Log Run

Name of Organization Running Log

SCREEN DATA

Diameter - Inches 2 Length - Feet 40 Slot Size - Inches .010

Screen Type Stainless steel Depth to Bottom - Feet 1200

GEOLOGIC DATA (Office Use Only)

Surface Elev.	Geologic Unit	Unit Thickness	Depth to Top
Subs. SWL	Date	Analysis	Aquifer Test


Driller's Remarks

DESCRIPTION OF FORMATIONS ENCOUNTERED	FROM	TO	FORMATIONS (Continued)	FROM	TO
<u>Surface Deposits</u>	<u>0</u>	<u>18</u>	<b>RECEIVED</b>  OCT 26 1989  Department of Natural Resources Bureau of Land & Water Resources		
<u>Forest Hill</u>	<u>18</u>	<u>50</u>			
<u>Yezoo Clay</u>	<u>50</u>	<u>520</u>			
<u>Sand - lignite</u>	<u>520</u>	<u>540</u>			
<u>Shale</u>	<u>540</u>	<u>615</u>			
<u>Sand</u>	<u>615</u>	<u>625</u>			
<u>Sandy shale</u>	<u>625</u>	<u>660</u>			
<u>Shale</u>	<u>660</u>	<u>1035</u>			
<u>Sand</u>	<u>1035</u>	<u>1200</u>			

IF MORE SPACE IS NEEDED, USE BACK

If well telescopes please  
sketch and show depths.

GROUND LEVEL

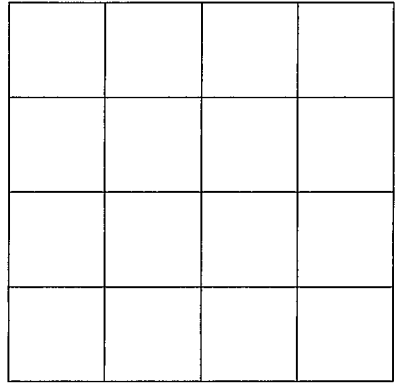

SECTION \_\_\_\_\_

Please indicate well location X.

ADDITIONAL INFORMATION

If more than one screen,  
show location of each on sketch.