

STATE WELL REPORT

Part 1

Driller's Log

Mississippi Department of Environmental Quality
Office of Land and Water Resources
P.O. Box 2309
Jackson, MS 39225-2309
(601)961-5210
(601)360-0535 (fax)

For Office Use Only:

Well #: V95
Aquifer: _____
E-Log #: _____

County: Madison
Permit #: _____
Driller: Greg Taylor
Date drilling completed: DEC 3, 2015

State Law requires that this report be prepared by the license holder responsible for the work and filed with the Department at the above address within 30 days of completion of drilling of the well or borehole.

Well Owner Information (Landowner if borehole is not for a water well)	Well or Borehole Location <u>32° 27' 43" N 90° 10' 04" W</u>
Owner Name: <u>Matt Hollifield</u>	Latitude: <u>N 32° 27.732'</u> Longitude: <u>W 090° 10.080'</u>
Mailing Address: <u>400 MADIE LANE</u>	Method of Lat/Long (check one): Conventional Survey _____
<u>Madison</u> <u>MS</u> <u>39110</u>	USGS quad _____, Hand-held GPS <input checked="" type="checkbox"/> , Survey-grade GPS _____
City State Zip Code	<u>SE 1/4 SW 1/4, Sec 11 T 7N R 1E</u>
Telephone No. <u>(601) 573-0123</u>	<u>20</u> Miles <u>NW</u> of <u>Ridgeland</u> (Distance) (Direction) (Nearest Town)

Well / Borehole Data	
Date drilling started: <u>Oct 14, 2015</u>	Date drilling completed: <u>DEC 3, 2015</u>
Hole depth: <u>200'</u>	Hole diameter: <u>4"</u>
Location of the source of any surface water used for drilling: _____	
Method of dosing and volume of Chlorine used in drilling and development: _____	
Logs run (circle all applicable): No log run <input type="checkbox"/> Electric <input type="checkbox"/> Gamma Ray <input type="checkbox"/> Density <input type="checkbox"/> Sonic <input type="checkbox"/> Neutron <input type="checkbox"/> Other: _____	
Name of organization running log(s): _____	
Purpose of borehole (circle one): Water Well <input type="checkbox"/> Geotechnical/Geological Investigation <input type="checkbox"/> <u>Ground Source Heat Pump</u> <input checked="" type="checkbox"/>	
Seismic Survey <input type="checkbox"/> Other (describe) _____	
<i>If drilling is not related to water well construction, skip the remainder of this block</i>	
Purpose of Well (circle all applicable): Home <input type="checkbox"/> Industrial <input type="checkbox"/> Public Supply <input type="checkbox"/> Irrigation <input type="checkbox"/> Fish Culture <input type="checkbox"/>	
Other (describe): _____	
If a flowing well, method of flow regulation: Valve _____ Other (describe) _____	
Static Water Level: _____ feet [above or below] land surface Date measured: _____ (circle one)	
Method of measurement (circle one): Steel tape <input type="checkbox"/> Electric tape <input type="checkbox"/> Air line <input type="checkbox"/> Other (describe): _____	
Well depth: _____ Well grouted to a depth of: _____ feet Type of grout (circle one): Neat Cement <input type="checkbox"/> <u>Bentonite</u> <input checked="" type="checkbox"/> Mix <input type="checkbox"/>	
Casing length: _____ feet Casing diameter: _____ inches Type of casing: _____	
Screen length: _____ feet Screen diameter: _____ inches Type of screen: _____	
Screen slot size: _____ inches Setting depth: From _____ feet to _____ feet	
Type of completion (circle all applicable): Gravel packed <input type="checkbox"/> Underreamed <input type="checkbox"/> Open hole <input type="checkbox"/> Natural Development <input type="checkbox"/>	
Other (describe): _____	
Top of lap pipe or reduction in casing: _____ feet	
<i>If telescoped or more than one screen, describe on next page</i>	

RECEIVED

DEC 29 2015

Form: OLWR-SWR-1A (4/13)
BY: OLWR

[The page contains extremely faint and illegible text, likely bleed-through from the reverse side of the document. The text is scattered across the page and does not form any recognizable words or sentences.]

County: Madison
 Permit #: _____

For Office Use Only:
 Well #: V95

The sketch below only required for water wells

If well telescopes, show depths on sketch.

Description of formations encountered must be provided for all wells and boreholes, unless specifically exempted by regulations

Ground Level →

Description of Formations Encountered	From (depth)	To (depth)
Red Sand Blue Clay	Ground level	30'
Blue Clay	30'	200'
200' T/D		

If more than one screen, show location of each on sketch

Sketch the property layout and include the following:


- 1) the well location
- 2) any permanent structures on the property that may aid in locating the well
- 3) any roads, power lines, or other items that may aid in locating the property and the well
- 4) north arrow

#1 N 32° 27.732' #5 N 32° 48.940' 4 3 2 0
 W 090° 10.080' W 090° 39.911' 0 0 0 0

#2 N 32° 27.733' #6 N 32° 27.733' 7 0 0 0
 W 090° 10.082' W 090° 10.081'

#3 N 32° 27.729' #7 N 32° 27.732' 0 6 0 0
 W 090° 10.082'

#4 N 32° 27.733' W 090° 10.086' 0 6 0 0
 W 090° 10.084'

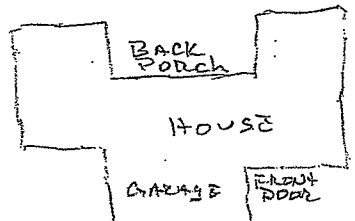

CREEK

Landowner Name: Matt Holliman

I HEREBY CERTIFY that the well/borehole was drilled, constructed, and completed in accordance with all applicable requirements of the Mississippi Department of Environmental Quality and the Mississippi Department of Health regulations, if applicable, and state laws.

Martin E Herndon 0-455
 Print Name of Responsible Licensee and License No.

12-28-15
 Date

Martin E Herndon
 Signature of Licensee

RECEIVED

Form: OLWR-SWR-1B (4/13)
 DEC 29 2015

BY: OLWR

