

MISSISSIPPI DEPARTMENT OF NATURAL RESOURCES

Bureau of Land and Water Resources

Southport Mall

P.O. Box 10631

Jackson, Mississippi 39209

WATER WELL DRILLERS LOG

Madison  
V 2000

Aug. 10 1987 E.M. Burgess Well Madison  
 date well completed firm name county well located

LANDOWNER:

Odell Hudson

description of formations encountered

from

to

<u>Silt</u>	<u>0</u>	<u>30</u>
<u>Yazoo Clay</u>	<u>30</u>	<u>350</u>
<u>Meander bank</u>	<u>350</u>	<u>375</u>
<u>Sand shale</u>	<u>375</u>	<u>570</u>
<u>Fine sand</u>	<u>570</u>	<u>630</u>
<u>Sand</u>	<u>630</u>	<u>670</u>

JACKSON, MS.  
 (mailing address)

WELL LOCATION:

sec. 33 T 7 N R 1 E  
4 miles West of Ridgeland  
 (distance) (direction) (nearest town)

WELL PURPOSE: Home  
 (home, irrigation, municipal, industrial)

WELL COMPLETION DATA:

- (1) diameter (inches) 4
- (2) total depth (feet) 670
- (3) static water level (feet) 225 below top of ground.
- (4) casing PVC 640  
 (material) (depth)
- 4 if telescope see back.  
 (size)
- (5) screen 30 640  
 (length) (depth to top)
- 4 PVC  
 (size) (material)
- (6) pump 1 10  
 (HP) (yield gpm)
- (type power)
- (7) electric log no  
 (yes or no)
- (organization running log)

RECEIVED

AUG 26 1987


Department of Natural Resources  
 Bureau of Land & Water Resources

(8) how well bottom plugged  
Sand Shale

DRILLERS REMARKS:

If well telescopes please sketch and show depths.

GROUND LEVEL

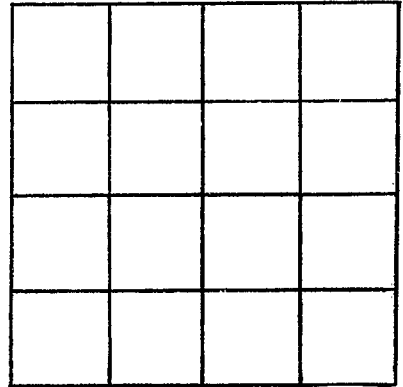

SECTION \_\_\_\_\_

Please indicate well location X.

ADDITIONAL INFORMATION

If more than one screen,  
show locations of each on sketch.