

MADISON MISSISSIPPI BOARD OF WATER COMMISSIONERS

W

5-29-64

WATER WELL DRILLERS LOG

Handwritten signature

Date: 5/29, 1964, Driller: Frank Dely Beck County: Scott
(Name)

(1) Owner of Land: Dr. W.C. Warner
(Name)
Jackson, Miss.
(Address)

(2) Location: 1/4, 1/4, Sec. T. R.
5 miles N West of Fanning
(distance) (direction) (Nearest Town)

(3) Topography:
(Hilly) (Flat) (Level)

(4) Purpose of Well: Domestic
(Domestic Irrigation, Municipal, Industrial, Other)

Description & Color of Materials Sand, Clay, Red Clay, Shell, etc.	Thick-ness Feet	Depth Feet
<u>Brown Clay</u>	<u>0</u>	<u>42</u>
<u>Blue Clay</u>	<u>2</u>	<u>59</u>
<u>Shale, Mdy Sand, Shell</u>		
<u>+ Clay</u>		<u>320</u>
<u>Shale</u>		<u>390</u>
<u>Shale, Fine sand + shale</u>		<u>380</u>
<u>Shale, Mdy Sand + 7 sand</u>		<u>444</u>
<u>Shale</u>		<u>470</u>
<u>Shale + Mdy Sand</u>		<u>565</u>
<u>Shale</u>		<u>570</u>
<u>Sand</u>		<u>588</u>

Information upon completion of well:

(1) Diameter 2 inches.

(2) Total Depth 588 feet.

(3) Water Level 100 feet below top of ground.

(4) Cased to 578, Size 2"


(5) Screen: Size 2", Length 10ft.

(6) Were any formations sealed against pollution?
 yes, X no.

If YES depth of formation

Why

Drillers Remarks:

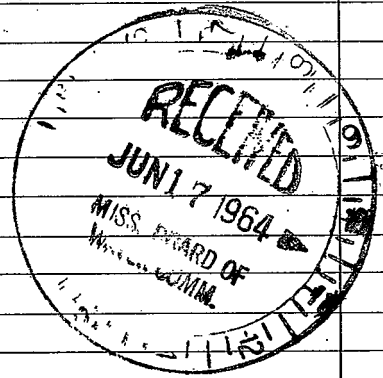

(Use Back Side)

Well No.

