


WATER WELL DRILLERS LOG

W 9
8-62

Date: Aug, 1962, Driller: DAVID BERRY County: Madison
(Name)

**Madison
CODED**

	Description & Color of Materials Sand, Clay, Red Clay, Shell, etc.	Thick- ness Feet	Depth Feet
(1) Owner of Land: <u>Louis S. Culley</u> (Name) <u>& One Noble - Madison Miss</u> (Address)	Kelly clay		20 40
(2) Location: <u>1/4</u> , <u>1/4</u> , Sec. <u>15</u> T <u>7</u> R <u>2E</u> , <u>3</u> miles - <u>E</u> , of <u>MADISON</u> , (distance) (direction) (Nearest Town)	Blue clay Blue clay Gumbo Gumbo	20 20 20 20	60 80 100 120
(3) Topography: <u>Hilly</u> (Hilly) (Flat) (Level)	Gumbo Blue clay & Gumbo	20 20	140 160
(4) Purpose of Well: <u>DOMESTIC</u> (Domestic Irrigation Municipal, Industrial, Other)	Blue clay Blue clay Blue clay	20 20 20	180 200 240
Information upon completion of well:			
(1) Diameter <u>6 1/4</u> inches.	Blue clay	20	300
(2) Total Depth <u>690'</u> feet.	Clay & Sand at 315'	20	320
(3) Water Level _____ feet below top of ground.	Sand Sand	20 20	340 360
(4) Cased to <u>415'</u> , Size <u>6"</u>	Sand Strat of Sand	20 20	380 400
(5) Screen: Size <u>4"</u> , Length <u>44</u>	" " " Casing set at 415'	20	420
(6) Were any formations sealed against pollution? _____ yes, _____ no.	Strat of Sand " " "	20 20	440 460
If YES depth of formations _____	Broken Sandy clay Hard clay	20 20	480 500
Why _____	" " Sandy clay	20 20	520 540
Drillers Remarks _____	" " Sand	20 35	560 600
	Sand with 3' Break (in middle)	18	618

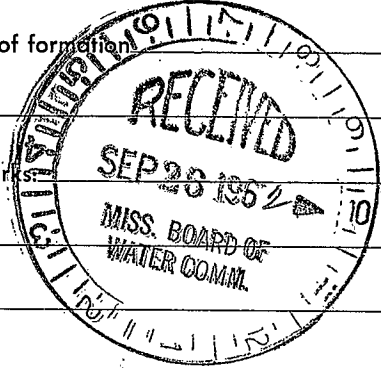

(Use Back Side)

Well No.

20 - 658
 16 - 648
 10 - 655
 10 - 658
 20 - 658
 2 - 690

Mountain Hotel
 Hotel
 Hotel
 " Hotel
 Hotel
 Hotel