

MADISON MISSISSIPPI BOARD OF WATER COMMISSIONERS

W 18

10-3-63

WATER WELL DRILLERS LOG

CODED

Date: 10/3, 1963, Driller: M Ka County Madison
(Name)

- (1) Owner of Land: Howard Brown
(Name)
Jackson Miss
(Address)
- (2) Location: 1/4, 1/4, Sec. 10 T. 7R2E,
5 miles E, of Madison,
(distance) (direction) (Nearest Town)
- (3) Topography: (Hilly) (Flat) (Level)
- (4) Purpose of Well: (Domestic Irrigation)
 Municipal, Industrial, Other

Description & Color of Materials Sand, Clay, Red Clay, Shell, etc.	Thick- ness Feet	Depth Feet
<u>Yellow Clay</u>	<u>0</u>	<u>21</u>
<u>Blue Clay</u>	<u>21</u>	<u>42</u>
<u>Sea Shell - Sand</u>	<u>42</u>	<u>336</u>
<u>Brown Sandy Clay</u>	<u>336</u>	<u>378</u>
<u>Fine Sand</u>	<u>378</u>	<u>525</u>
<u>Med Sand</u>	<u>525</u>	<u>609</u>
<u>Med Sand</u>	<u>609</u>	<u>630</u>
<u>Med Sand</u>	<u>630</u>	<u>657</u>

Information upon completion of well:


- (1) Diameter 2 inches.
- (2) Total Depth 657 feet.
- (3) Water Level 108 feet below top of ground.
- (4) Cased to _____, Size _____
- (5) Screen: Size 007, Length 20
- (6) Were any formations sealed against pollution?
 _____ yes, no.

3 HP air unit

CODED

If YES, depth of formation _____
 Why _____

Drillers Remarks: _____

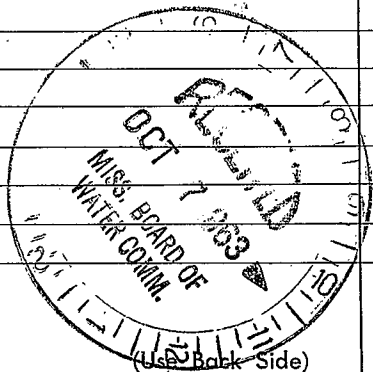

Well No.

100