

MADISON MISSISSIPPI BOARD OF WATER COMMISSIONERS

W 19

11-29-64

WATER WELL DRILLERS LOG

**CODED**

Date: 11/29, 1964, Driller: Frank Drilling County: Itawamba  
(Name)

(1) Owner of Land: Richard Parker  
(Name)

Jackson, Miss.  
(Address) 30 2 25

(2) Location: 1/4, 1/4, Sec. 8 T 7 R 1E,  
1 1/2 miles North, of Ridgeland  
(distance) (direction) (Nearest Town)

(3) Topography: \_\_\_\_\_  
(Hilly) (Flat) (Level)

(4) Purpose of Well: Home  
(Domestic Irrigation  
Municipal, Industrial, Other)

Description & Color of Materials Sand, Clay, Red Clay, Shell, etc.	Thick- ness Feet	Depth Feet
<u>yellow clay</u>	<u>0</u>	<u>30</u>
<u>blue clay</u>		<u>266</u>
<u>shale</u>		<u>410</u>
<u>blue sand, sand &amp; lignite</u>		<u>435</u>
<u>shale &amp; soft clay</u>		<u>470</u>
<u>sand &amp; shaly shale</u>		<u>480</u>
<u>shale, (soft)</u>		<u>512</u>
<u>shale</u>		<u>538</u>
<u>fine sand &amp; shaly shale</u>		<u>576</u>
<u>shale</u>		<u>582</u>
<u>fine sand &amp; shaly shale</u>		<u>655</u>
<u>fine sand</u>		<u>744</u>

Information upon completion of well:

(1) Diameter 2 inches.

(2) Total Depth 734 feet.

(3) Water Level 220 feet below top of ground.

(4) Cased to 714, Size 2"

(5) Screen: Size 2", Length 20 ft.


(6) Were any formations sealed against pollution?  
\_\_\_\_\_ yes,  no.

If YES depth of formation \_\_\_\_\_

Why \_\_\_\_\_

Drillers Remarks: \_\_\_\_\_

**CODED**

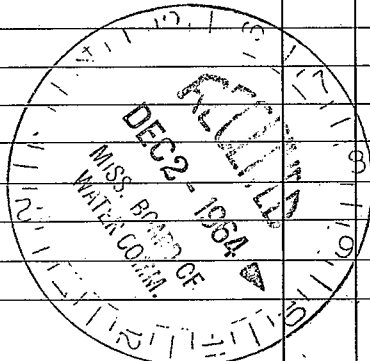

(Use Back Side)

Well No.

100