

MADISON MISSISSIPPI BOARD OF WATER COMMISSIONERS

W20

WATER WELL DRILLERS LOG

5-1-65

Date: 5/1, 1965, Driller East Drilling Co. (Name)

**CODED**

(1) Owner of Land: Clinton Wilson  
 (Name)  
Jackson, Miss.  
 (Address)  
 (2) Location: 1/4, 1/4, Sec. 31 T2 R2E  
Northwest of Lucas  
 (distance) (direction) (Negro/Town)  
1/4 mi East of Con Fed Corp  
 (3) Topography: \_\_\_\_\_  
 (Hilly) (Flat) (Level)  
 (4) Purpose of Well: Home  
 (Domestic Irrigation  
 Municipal, Industrial, Other)


Description & Color of Materials Sand, Clay, Red Clay, Shell, etc.	Thick- ness Feet	Depth Feet
Chalky clay	0	26
Blue clay		200
Blue shale		266
Shale + shls lignite		327
Shale, soft clay + "		368
Shale		388
Shale + shls sand		410
Shale + shls fine sand		434
Fine sand + shls shale		451
Fine sand		477
Shale + shls sand		487
Sand		492
Shale + shls sand		518
Fine sand		564
Sand + shls shale		575
Fine sand		600
Shale		739
Shale + shls rock		760
Shale + shls silt		801
soft brown clay + lignite		822
Shale		846
Fine sand + shls shale		864
Fine sand		890
Shale		900
Fine sand		906
Fine sand + shls shale		917
Fine sand		946

Information upon completion of well:

(1) Diameter 7 1/2" inches.  
 (2) Total Depth 946 feet.  
 (3) Water Level 240 feet below top of ground.  
 (4) Cased to 924, Size 2"  
 (5) Screen: Size 2", Length 22ft  
 (6) Were any formations sealed against pollution?  
 \_\_\_\_\_ yes, X no.

If YES depth of formation \_\_\_\_\_  
 Why \_\_\_\_\_

Drillers Remarks: \_\_\_\_\_

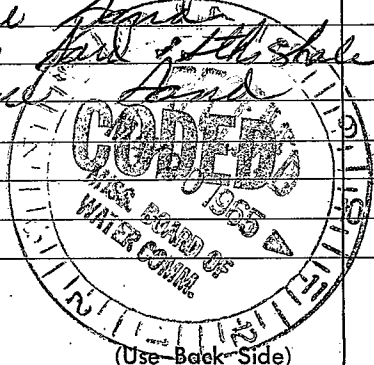

Well No. \_\_\_\_\_

(Use Back Side)

