

MADISON MISSISSIPPI BOARD OF WATER COMMISSIONERS

W 40

10-15-64

WATER WELL DRILLERS LOG

CODED

Date: Oct. 15, 1964, Driller: Layne-Central Co. County: Madison

(Name)

(1) Owner of Land: Town of Madison
(Name)

Madison, Mississippi
(Address)

(2) Location: 1/4, 1/4, Sec. 8 T. 2, R. 2E

 miles of
(distance) (direction) (Nearest Town)

(3) Topography:
(Hilly) (Flat) (Level)

(4) Purpose of Well: municipal
(Domestic Irrigation
Municipal, Industrial, Other)

Description & Color of Materials Sand, Clay, Red Clay, Shell, etc.	Thick- ness Feet	Depth Feet
top soil	5	5
yellow clay	25	30
blue (Yazoo) clay	59	89
shale	227	316
shale-stks sand	45	361
shale	46	407
sandy shale	114	521
sand	66	587
shale	3	590

Information upon completion of well:

(1) Diameter 10 inches.

(2) Total Depth 589 feet.

(3) Water Level 133 feet below top of ground.

(4) Cased to 518', Size 10"

(5) Screen: Size 6", Length 60'

(6) Were any formations sealed against pollution?


yes, no.

If YES depth of formation 518'

Why required

Drillers Remarks:

CODED

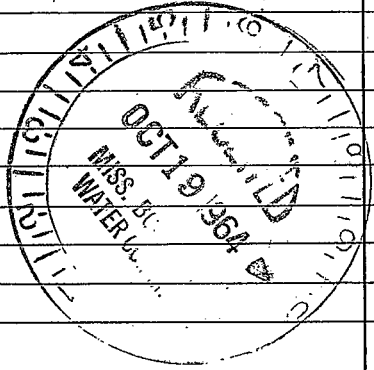

(Use Back Side)

Well No.

(K)