

ELOG # 161

Madison  
W 42  
8-67  
Elec Log  
8/13/19

MISSISSIPPI  
BOARD OF WATER COMMISSIONERS  
416 North State Street  
Jackson, Mississippi 39201

**CODED**

WATER WELL DRILLERS LOG

date well completed 19 67 Waterville, Inc firm name Madison county well located

LANDOWNER: George W. Elliott

description of formations encountered	from	to
<u>Weathered Red Sand</u>	<u>0</u>	<u>18</u>
<u>Blue Clay</u>	<u>18</u>	<u>382</u>
<u>Grey sandy shale. Top</u>	<u>382</u>	<u>422</u>
<u>Grey shale - Rock streaks</u>	<u>422</u>	<u>428</u>
<u>Grey medium sand</u>	<u>428</u>	<u>600</u>
<u>Blue clay</u>	<u>600</u>	<u>616</u>
	<u>TD</u>	<u>616</u>

RED

Madison, Miss  
(mailing address)

WELL LOCATION:


sec. 22 T 7 N R. 2 E  
3 miles East of Madison  
(distance) (direction) (nearest town)

WELL PURPOSE: Domestic  
(home, irrigation, municipal, industrial)

WELL COMPLETION DATA:

- (1) diameter (inches) 4 x 3"
- (2) total depth (feet) 616
- (3) static water level (feet) 198 below top of ground.
- (4) casing 4" 253  
(material) (depth)  
3" to 506  
(size) If telescope see back.
- (5) screen 30' 506  
(length) (depth to top)  
1 1/2" stainless steel  
(size) (material)
- (6) pump 1 14 gpm  
(HP) (yield gpm)  
200 volts Submersible  
(type power)
- (7) electric log yes  
(yes or no)  
Miss. G. S.  
(organization running log)
- (8) how well bottom plugged NA

**CODED**

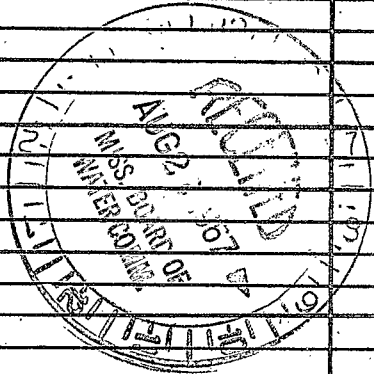

DRILLERS REMARKS: Pump Setting  
231'  
Elevation 370'

Ⓢ

