

ELOG # 162

MISSISSIPPI
BOARD OF WATER COMMISSIONERS
416 North State Street
Jackson, Mississippi 39201

CODED

WATER WELL DRILLERS LOG

9-20-1967 date well completed
Forest Drilling firm name
Madison county well located

LANDOWNER: Mrs. Hazel Wood

Rt 1. Box 257

Madison, Miss.
(mailing address)

description of formations encountered

from to

| | | |
|--------------------------|---|-----|
| Brown Clay | 0 | 20 |
| Clay + Red sand | | 36 |
| Yellow Clay | | 201 |
| Shale | | 281 |
| Shale + 5th Lm. Loh | | 321 |
| Shale + silt | | 361 |
| Soft Shale + silt + sand | | 381 |
| Soft Shale + silt | | 421 |
| Shale + 5th Lm. Loh | | 441 |
| Shale | | 446 |
| Sand + 5th Clay | | 471 |
| Fine Sand | | 508 |

WELL LOCATION:

SE 1/4 SE 1/4
sec. 6 T 3 N R 3 E
S W
6 miles North of Madison
(distance) (direction) (nearest town)

WELL PURPOSE: Home
(home, irrigation, municipal, industrial)

WELL COMPLETION DATA:

- (1) diameter (inches) 2"
- (2) total depth (feet) 508
- (3) static water level (feet) _____ below above top of ground.

(4) casing Galv. 503
(material) (depth)

2" if telescope see back.
(size)

(5) screen 5 ft 503
(length) (depth to top)

2" Corb. Stair
(size) (material)

(6) pump 3 1000 GPH
(HP) (yield gpm)


Elect
(type power)

(7) electric log yes
(yes or no)

U.S. Geog.
(organization running log)

(8) how well bottom plugged backward
yellow


CODED

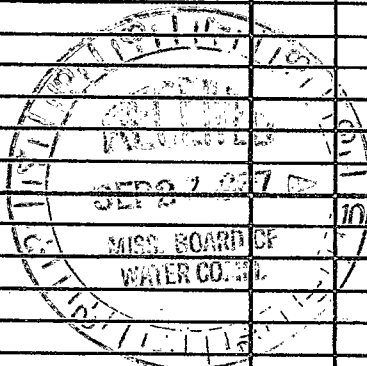

DRILLERS REMARKS:

If well telescopes please sketch and show depths.

GROUND LEVEL

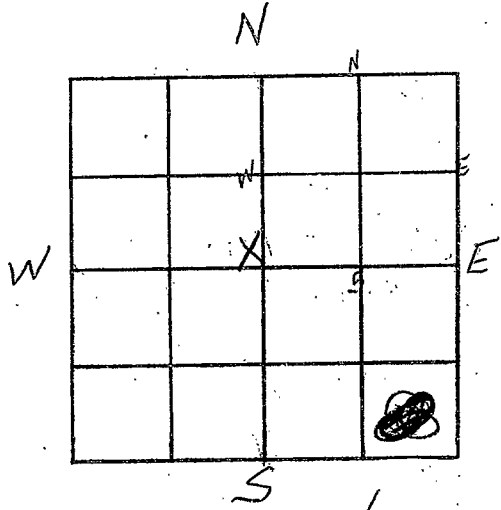

SECTION 6

Please indicate well location X.

ADDITIONAL INFORMATION

If more than one screen, show locations of each on sketch.