

Madison  
W49  
4-14-69

MISSISSIPPI  
BOARD OF WATER COMMISSIONERS  
416 North State Street  
Jackson, Mississippi 39201

CODED  
CODED

WATER WELL DRILLERS LOG

4/14 1969 Forest Dilling Madison  
date well completed firm name county well located

LANDOWNER: Joe Broadway	description of formations encountered	from	to
1241 Marie Drive Jackson, Miss. (mailing address)	Brown clay	0	35
	Blue clay	35	204
	Clay + stb limestone	204	224
	Shale + stb rock	224	327
	Sand & shale	327	365
	Shale	365	430
	2 hole + stb fine sand	430	553
	Fine sand	553	573
	Fair sand	573	615
	Fine sand	615	635
	Fine sand + stb clay	635	655
WELL LOCATION: sec. 10 T. 17 N. R. 2 E 7 miles N/E of MADISON (distance) (direction) (nearest town)			
WELL PURPOSE: home (home, irrigation, municipal, industrial)			
WELL COMPLETION DATA:			
(1) diameter (inches) 2"			
(2) total depth (feet) 625'			
(3) static water level (feet) 134' below top of ground.			
(4) casing (material) Galv (depth) 610'			
2" (size) if telescope see back.			
(5) screen 15' (length) 610' (depth to top)			
2" (size) Stainless Steel (material)			
(6) pump 5 (HP) 15 (Acf) (yield gpm)			
Electric (type power)			
(7) electric log no (yes or no)			
(organization running log)			
(8) how well bottom plugged 2" Backwash Valve			
DRILLERS REMARKS:			


CODED  
CODED  
CODED

MAY 1 - 1969

MISS. BD. OF  
WATER COMMISSIONERS

If well telescopes please  
sketch and show depths.

GROUND LEVEL

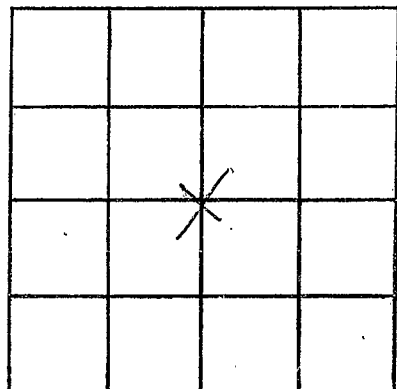

SECTION 10

Please indicate well location X.

ADDITIONAL INFORMATION

If more than one screen,  
show locations of each on sketch.