

CODED

MISSISSIPPI
BOARD OF WATER COMMISSIONERS
416 North State Street
Jackson, Mississippi 39201

ELOG #188

WATER WELL DRILLERS LOG

Madison
W46
8-25-69

8-25 1969 ~~8-25-69~~ H. B. Pitts Madison
date well completed firm name county well located

LANDOWNER: W. W. Ford

description of formations encountered

(mailing address)

description of formations encountered	from	to
Red & Yellow Clay	0	58
Blue clay shale	58	365
Hard clay shale	365	423
Shale & shells, lignite	423	445
sand	445	520
sand & shale str.	520	608
Soft clay	608	712
sand	712	738
shale (very hard str.)	738	883

WELL LOCATION:
sec. 33 T. 7 N. R. 3 E
6 miles N of slackton
(distance) (direction) (nearest town)

WELL PURPOSE: Home
(home, irrigation, municipal, industrial)


WELL COMPLETION DATA:

- (1) diameter (inches) 4 X 2"
- (2) total depth (feet) 883'
- (3) static water level (feet) 154 below top of ground.
- (4) casing steel, 580'
(material) (depth)
4 X 2 if telescope see back.
(size)
- (5) screen 20', 580'
(length) (depth to top)
2", Stainless Steel
(size) (material)
- (6) pump 3, 18
(HP) (yield gpm)
elect.
(type power)
- (7) electric log Yes
(yes or no)
U. S. G. S.
(organization running log)
- (8) how well bottom plugged
Backwash Valve

DRILLERS REMARKS:
Drilled to 883'
Completed 580 to 600'

Aug 26 1969
MISS. DEP. OF
WATER CONTROL

If well telescopes please sketch and show depths.

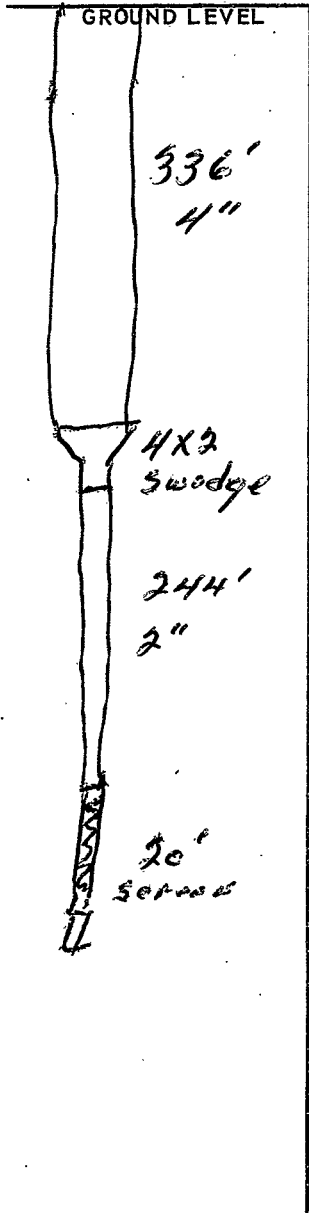

	+		

SECTION 33

Please indicate well location X.

ADDITIONAL INFORMATION

If more than one screen,
show locations of each on sketch.