

MADISON

MISSISSIPPI BOARD OF WATER COMMISSIONERS

CODED

W47

6-62

WATER WELL DRILLERS LOG

Date: JUNE, 1962, Driller: MCNEECE DRILLING Co County MADISON

(Name)

(1) Owner of Land: MR HARRY JACOBS (Name)	Description & Color of Materials Sand, Clay, Red Clay, Shell, etc.	Thick- ness Feet	Depth Feet
RT3 Box 22, JACKSON MISS (Address)	SURFACE SOIL	12	12
(2) Location: SE 1/4, NE 1/4, Sec. 32 T12E 2 miles N of JACKSON (distance) (direction) (Nearest Town)	YELLOW MARL	23	35
(3) Topography: HILLY (Hilly) (Flat) (Level)	GREY SHALE	295	330
(4) Purpose of Well: DOMESTIC (Domestic Irrigation Municipal, Industrial, Other)	ROCK	10	340
	SAND, SHELL & SHALE	24	364
	FINE SAND, SHALE & LIG	40	404
	SHALE & SAND	44	448
	FINE SAND	65	513
	COARSE SAND	64	577


Information upon completion of well:

- (1) Diameter ~~4x2 1/2~~ inches.
- (2) Total Depth 577 feet.
- (3) Water Level 130 feet below top of ground.
- (4) Cased to 340', Size 4"
- (5) Screen: Size 2 1/2", Length 40'
- (6) Were any formations sealed against pollution?
yes, no.

If YES depth of formation _____

Why _____

Drillers Remarks: _____

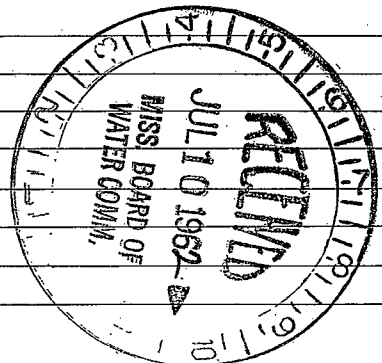

(Use Back Side)

Well No. 34

