

ELOG # 194

**CODED**

MISSISSIPPI  
BOARD OF WATER COMMISSIONERS  
416 North State Street  
Jackson, Mississippi 39201

MAR 23 1977

MISS. BD. OF  
WATER COMM.

MADISON  
W 50  
7-22-70

WATER WELL DRILLERS LOG

7-22-70 date well completed 19 DAVID BERRY firm name MADISON county well located

LANDOWNER:	description of formations encountered	from	to
Natchez Trace Village	CLAY	0	332
MADISON, MISS. (mailing address)	SAND	332	408
	SAND & YOCK	408	469
	SAND & Shale	469	489
	FINE SAND	489	549
	Shales	549	568
	Hard CLAY	568	588
	SAND FINE	588	608
	BROKEN SAND	608	629
	SAND	629	684

WELL LOCATION:  
sec. 22 T 7 N R 2 E  
S miles E of Madison  
(distance) (direction) (nearest town)

WELL PURPOSE: MUNICIPAL  
(home, irrigation, municipal, industrial)

- WELL COMPLETION DATA:
- (1) diameter (inches) 6 1/4
  - (2) total depth (feet) 684
  - (3) static water level (feet) 116 below top of ground
  - (4) casing A.P.I. 6 1/2 (material), 643 (depth)  
6 1/4 (size) if telescope see back.
  - (5) screen 45 (length), (depth to top)  
4" (size), STAINLESS (material)
  - (6) pump 20 HP (HP), (yield gpm)  
Caw. (type power)
  - (7) electric log (yes or no)  
Miss. Dco. (organization running log)
  - (8) how well bottom plugged


**CODED**

DRILLERS REMARKS:

ⓧ

If well telescopes please sketch and show depths.

GROUND LEVEL

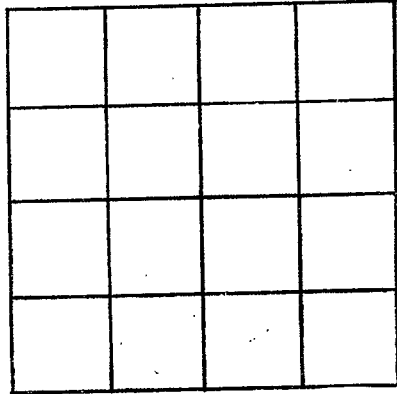


SECTION \_\_\_\_\_

Please indicate well location X.

ADDITIONAL INFORMATION

400 ft  
6"

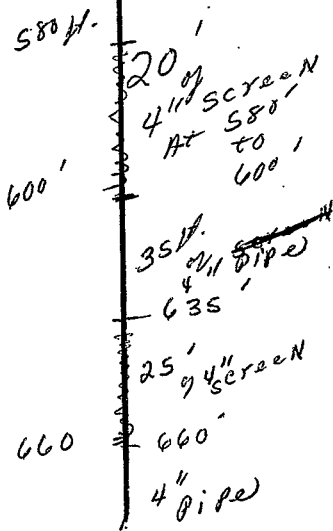

If more than one screen, show locations of each on sketch.