

W57  
4-7-65

WATER WELL DRILLERS LOG

**CODED**

Date: 4-7-, 1965, Driller: ELLS & HALL County MADISON

(Name)

- (1) Owner of Land: M. B. GALLAGER  
(Name)  
RICES DR RIDGELAND MISS  
(Address)
- (2) Location: NE 1/4, NW 1/4, Sec. 29 T20R2E  
1 1/2 miles E, of RIDGELAND  
(distance) (direction) (Nearest Town)
- (3) Topography: HILLY  
(Hilly) (Flat) (Level)
- (4) Purpose of Well: DOMESTIC  
(Domestic Irrigation  
Municipal, Industrial, Other)

Description & Color of Materials Sand, Clay, Red Clay, Shell, etc.	Thick- ness Feet	Depth Feet
<u>SURFACE SOIL</u>	<u>3</u>	<u>3</u>
<u>GREY MARL</u>	<u>42</u>	<u>45</u>
<u>YAZOO CLAY</u>	<u>312</u>	<u>357</u>
<u>MOODY BRANCH</u>	<u>21</u>	<u>378</u>
<u>SHALE</u>	<u>45</u>	<u>423</u>
<u>SAND PINE</u>	<u>15</u>	<u>438</u>
<u>SAND SHALE &amp; ROCK</u>	<u>128</u>	<u>556</u>
<u>SAND (GOOD)</u>	<u>28</u>	<u>584</u>

Information upon completion of well:


- (1) Diameter 4x2 inches.
- (2) Total Depth 584 feet.
- (3) Water Level 168 feet below top of ground.
- (4) Cased to 250' / 314', Size 4" / 2"
- (5) Screen: Size 2, Length 20
- (6) Were any formations sealed against pollution?  
\_\_\_\_\_ yes, X no.

**CODED**

If YES depth of formation \_\_\_\_\_

Why \_\_\_\_\_

Drillers Remarks: \_\_\_\_\_

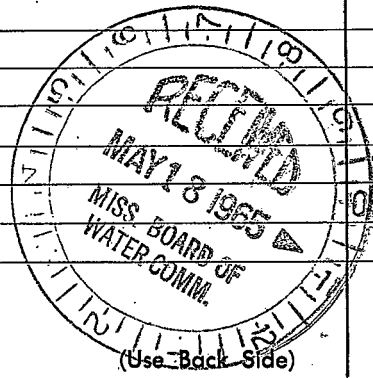

Well No. 10

