

MADISON

K/61

3-22-74

F Log # 229

3/22

date well completed

MISSISSIPPI BOARD OF WATER COMMISSIONERS
416 North State Street
Jackson, Mississippi 39201

CODED

WATER WELL DRILLERS LOG

1974 Singer-Lema Central Div


firm name

Madison

county well located

LANDOWNER:	description of formations encountered	from	to
Town of Madison	Top Soil	0	2
Madison, Miss (mailing address)	Hard yellow Clay	2	30
WELL LOCATION:	Greys Clay	30	280
sec. <u>8</u> T. <u>7</u> N. R. <u>2</u> E.	Hard Shale	280	304
(distance) miles (direction) of (nearest town)	Hard Limestone	304	334
WELL PURPOSE: <u>Municipal</u> (home, irrigation, municipal, industrial)	Shale and Sand Strata	334	380
WELL COMPLETION DATA:	Shale and Strs. of Lignite	380	466
(1) diameter (inches) <u>16"</u>	Shale and fine Sand Strata	466	525
(2) total depth (feet) <u>607'</u>	Sand	525	622
(3) static water level (feet) _____ below above top of ground.	Sand and Shale	622	705
(4) casing <u>Steel</u> <u>532'</u> (material) (depth)			
<u>16"</u> If telescope see back. (size) <u>4 5/8"</u>			
(5) screen <u>60</u> <u>541'</u> (length) (depth to top)			
<u>8</u> <u>St. Steel W.W.</u> (size) (material)			
(6) pump <u>75</u> <u>500</u> (HP) (yield gpm)			
<u>Electric</u> (type power)			
(7) electric log <u>yes</u> (yes or no)			
<u>Miss Geo. Survey</u> (organization running log)			
(8) how well bottom plugged <u>Valve</u>			
DRILLERS REMARKS:			

CODED

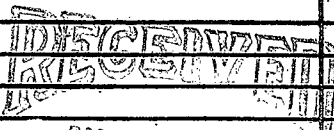

AUG 22 1974

MISS. B.O. WATER COMM



If well telescopes please sketch and show depths.

GROUND LEVEL

SECTION

Please indicate well location X.

ADDITIONAL INFORMATION

If more than one screen, show locations of each on sketch.