

MADISON

W62

5-17-74

FLW#230

5-17

date well completed

MISSISSIPPI  
 BOARD OF WATER COMMISSIONERS  
 416 North State Street  
 Jackson, Mississippi 39201

CODED

WATER WELL DRILLERS LOG

19 74 Singer-Lema Central Div. Madison  
 firm name county well located

LANDOWNER:	description of formations encountered	from	to
<u>Pearl River</u> <u>Valleywater Supply District</u> <u>Jackson, Miss.</u> (mailing address)	<u>Top Soil</u>	<u>0</u>	<u>2</u>
WELL LOCATION: sec. <u>28</u> T. <u>7</u> N. R. <u>2</u> E. (distance) (direction) (nearest town)	<u>Yellow Clay</u>	<u>2</u>	<u>23</u>
WELL PURPOSE: <u>Domestic</u> (home, irrigation, municipal, industrial)	<u>Hard Lense</u>	<u>23</u>	<u>310</u>
WELL COMPLETION DATA: (1) diameter (inches) <u>16"</u>	<u>Sand + Shale</u>	<u>310</u>	<u>344</u>
(2) total depth (feet) <u>673'</u>	<u>Hard Shale + Sand Sh.</u>	<u>344</u>	<u>401</u>
(3) static water level (feet) <u>110'</u> below above top of ground.	<u>Sandy Shale</u>	<u>401</u>	<u>458</u>
(4) casing <u>Steel</u> <u>587'</u> (material) (depth)	<u>Shale and Sand Strucks</u>	<u>458</u>	<u>520</u>
<u>16"</u> if telescope see back. (size) <u>+60' 8"</u>	<u>Shale and Sand</u>	<u>520</u>	<u>548</u>
(5) screen <u>70'</u> <u>597'</u> (length) (depth to top)	<u>Sand</u>	<u>548</u>	<u>664</u>
<u>8"</u> <u>Stainless Steel W.W.</u> (size) (material)	<u>Sandy Clay</u>	<u>664</u>	<u>682</u>
(6) pump <u>75</u> <u>500</u> (HP) (yield gpm)			
<u>Electric</u> (type power)			
(7) electric log <u>yes</u> (yes or no) <u>Miss. Geo. Survey</u> (organization running log)			
(8) how well bottom plugged <u>Valve</u>			
DRILLERS REMARKS:			

CODED

RECEIVED  
 MISSISSIPPI  
 BOARD OF WATER COMMISSIONERS


JUN 7 1974

WATER COMMISSIONERS



If well telescopes please  
sketch and show depths.

GROUND LEVEL

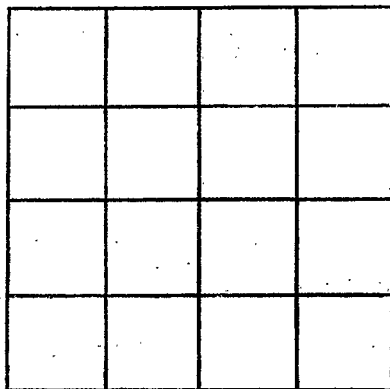

SECTION \_\_\_\_\_

Please indicate well location X.

ADDITIONAL INFORMATION

---

---

If more than one screen,  
show locations of each on sketch.