

Madison
 W65
 10-29-80
 Flog # 260

MISSISSIPPI BOARD OF WATER COMMISSIONERS
 416 North State Street
 Jackson, Mississippi 39201



WATER WELL DRILLERS LOG

18/29 1980 date well completed
 J. W. Quinn from name
 county well located

LANDOWNER: J. Sawyer
 SCY for (on 6/1/80)
 (mailing address)

description of formations encountered	from	to
yellow-clay	0	20
blue clay	20	325
shell	325	440
limestone shell	440	600
sand	600	640

WELL LOCATION:
 sec. 5 T 7 N R 2 E
 2 1/2 miles N of Madison
 (distance) (direction) (nearest town)

WELL PURPOSE:
 (home, irrigation, municipal, industrial)

- WELL COMPLETION DATA:
- (1) diameter (inches) 4
 - (2) total depth (feet) 698
 - (3) static water level (feet) 165 below above top of ground.
 - (4) casing P.V.C. 600 (material) (depth)
 4 (size) If telescope see back.
 - (5) screen 30 600 (length) (depth to top)
 4 (size) P.V.C. (material)
 - (6) pump 1 1/2 15 (HP) (yield gpm)
 Electric (type power)
 - (7) electric log yes (yes or no)
 m. J. S. (organization running log)
 - (8) how well bottom plugged Black crust value


CODED
 698 on 2 log
 DEPT. OF NATURAL RESOURCES
 BUREAU OF LAND & WATER RESOURCES

DRILLERS REMARKS:

MAR 20 1981
 RECEIVED

If well telescopes please
sketch and show depths.

GROUND LEVEL

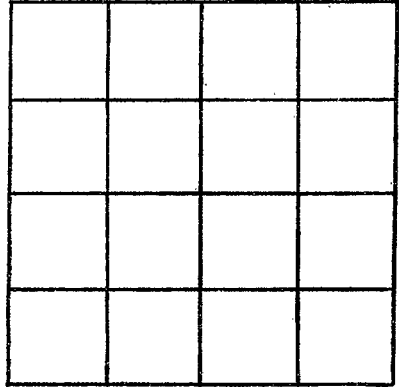

SECTION _____

Please indicate well location X.

ADDITIONAL INFORMATION

If more than one screen,
show locations of each on sketch.