

MADISON  
W 70

MISSISSIPPI DEPARTMENT OF NATURAL RESOURCES  
Bureau of Land and Water Resources  
Southport Mall  
P.O. Box 10631  
Jackson, Mississippi 39209  
WATER WELL DRILLERS LOG

COB

8-19-86 date well completed      19 STEVE GARDNER WATER WELL firm name      MADISON county well located

LANDOWNER: R-E.  
KEMP  
(mailing address)

WELL LOCATION:  
sec. 20 T 7 N R 2 E  
S W  
1 miles E of RIDGELAND  
(distance) (direction) (nearest town)

WELL PURPOSE: HOME  
(home, irrigation, municipal, industrial)


- WELL COMPLETION DATA:
- (1) diameter (inches) 5 3/4
  - (2) total depth (feet) 648
  - (3) static water level (feet) 207.6 below top of ground.
  - (4) casing PVC, 530 (material), (depth), (size) if telescope see back.
  - (5) screen 100, 630 (length), (depth to top) 4" PVC. (size), (material)
  - (6) pump 2, 35 (HP), (yield gpm) AC (type power)
  - (7) electric log YES (yes or no) BUREAU GEOLOGY (organization running log)
  - (8) how well bottom plugged BACK WASH VAL.

description of formations encountered	from	to
YAZO CLAY	1	340
CLAY AND SAND SHELL	340	370
COLE ROCK, FINE SAND LITTLE CLAY	370	480
SAND	480	648
RECEIVED FEB 10 1987		
Department of Natural Resources Bureau of Land & Water Resources		

DRILLERS REMARKS:

If well telescopes please sketch and show depths.

GROUND LEVEL

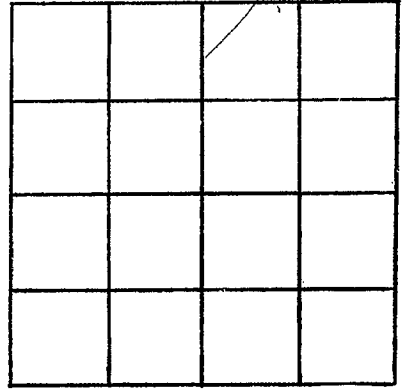

SECTION \_\_\_\_\_

Please indicate well location X.

ADDITIONAL INFORMATION

If more than one screen, show locations of each on sketch.