

MISSISSIPPI DEPARTMENT OF NATURAL RESOURCES

Bureau of Land and Water Resources

Southport Mall

P.O. Box 10631

CODED

Jackson, Mississippi 39209

WATER WELL DRILLERS LOG

MADISON  
W 72

9 22 86 19  
date well completed

STEVE GARDNER WATER well  
firm name

MADISON  
county well located

LANDOWNER: FRANK BLOSSMAN  
(mailing address)

WELL LOCATION:  
sec. 10 T. 7 N. R. 2 E. S. W.  
3 miles EAST of MADISON  
(distance) (direction) (nearest town)

WELL PURPOSE: HOME  
(home, irrigation, municipal, industrial)

WELL COMPLETION DATA:

(1) diameter (inches) 5 3/4

(2) total depth (feet) 626

(3) static water level (feet) 200 below top of ground.

(4) casing PVC 550 (material), (depth) 4" (size) if telescope see back.

(5) screen 70 590 (length), (depth to top) 4" PVC (size), (material)

(6) pump 5 40 (HP), (yield gpm) A.C. (type power)

(7) electric log YES (yes or no) BUREAU GEOLOGY (organization running log)

(8) how well bottom plugged BACK WASH VAL.

description of formations encountered	from	to
BUCK SHOT CLAY	1	45
YELLOW CLAY	45	125
YAZO CLAY CODED	125	180
YELLOW CLAY	180	300
BUCK SHOT CLAY		
LIZ NIGHT	300	345
LARGE SAND, SHELL ROCK		
SAND, CLAY LIZ NIGHT.	345	450
SAND, FINE	450	490
CLAY, SAND. LIME STONE ROCK	490	550
GOOD SAND LIME STONE ROCK	550	620
SAND AND CLAY	620	626

RECEIVED


FEB 10 1987

Department of Natural Resources  
Bureau of Land & Water Resources

DRILLERS REMARKS:

If well telescopes please sketch and show depths.

GROUND LEVEL

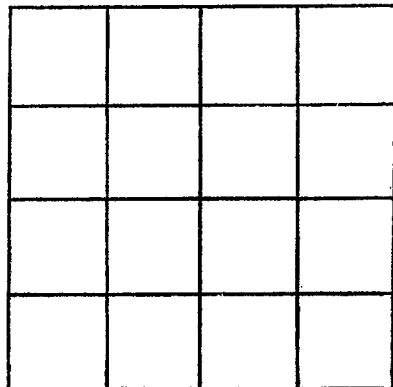

SECTION \_\_\_\_\_

Please indicate well location X.

ADDITIONAL INFORMATION

If more than one screen, show locations of each on sketch.