

MISSISSIPPI DEPARTMENT OF NATURAL RESOURCES

Bureau of Land and Water Resources

Southport Mall

P.O. Box 10631


Jackson, Mississippi 39209

WATER WELL DRILLERS LOG

Madison
W 77

June 15 1988 Laure-Central Co. Madison
date well completed firm name county well located

LANDOWNER:	description of formations encountered	from	to
<u>St. Catherine's Village</u> <u>Community Health Services</u> <u>919 Lakeland Dr.</u> <u>Jackson, MS 39216</u> (mailing address)			
<u>WELL LOCATION: NE 1/4 of SW 1/4 of</u> <u>sec. 18 T 7 N R 2 E NW 1/4</u> (distance) miles (direction) of (nearest town)	<u>Surface Clay</u>	<u>0</u>	<u>38'</u>
<u>WELL PURPOSE: Domestic</u> (home, irrigation, municipal, industrial)	<u>Blue Clay (40200)</u>	<u>38'</u>	<u>389'</u>
<u>WELL COMPLETION DATA:</u>	<u>Fine Sand & Clay Stks.</u>	<u>389'</u>	<u>470'</u>
(1) diameter (inches) <u>8" x 16"</u>	<u>Clay</u>	<u>470'</u>	<u>475'</u>
(2) total depth (feet) <u>710'</u>	<u>Fine Sand & Clay</u>	<u>475'</u>	<u>575'</u>
(3) static water level (feet) <u>622</u> below above top of ground.	<u>Fine Sand</u>	<u>575'</u>	<u>630'</u>
(4) casing <u>Steel</u> <u>8" - 409'</u> <u>16" - 273'</u> (material) (depth) <u>162'</u> <u>45'</u>	<u>Sandy Clay</u>	<u>630'</u>	<u>660'</u>
<u>8" x 16"</u> if telescope see back. <u>722</u> (size)	<u>Fine Sand</u>	<u>660'</u>	<u>722'</u>
(5) screen <u>40'</u> <u>660'</u> (length) (depth to top)	<u>Shale</u>	<u>722'</u>	<u>750'</u>
<u>16"</u> <u>Stainless Steel</u> (size) (material)			
(6) pump <u>30 Sub.</u> <u>239</u> (HP) (yield gpm)			
<u>208 Volt</u> (type power)			
(7) electric log <u>Yes</u> (yes or no)			
<u>Laure-Central Co.</u> (organization running log)			
(8) how well bottom plugged <u>Back</u>			
<u>Pressure Valve</u>			

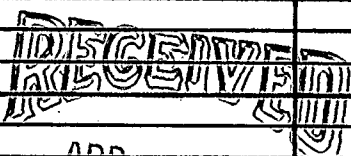


APR 25 1991

Dept. of Environmental Quality
Bureau of Land & Water Resources

DRILLERS REMARKS:

If well telescopes please
sketch and show depths.

GROUND LEVEL

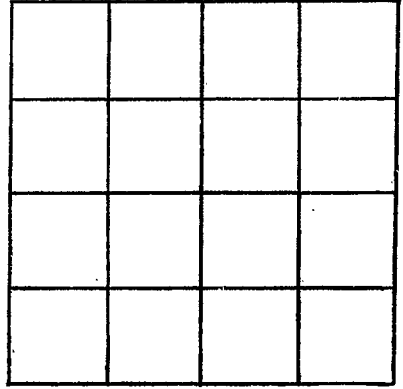

SECTION _____

Please indicate well location X.

ADDITIONAL INFORMATION

If more than one screen,
show locations of each on sketch.