

County: Madison
 Permit #: _____
 Driller: walker-hill Environmental, Inc.
 Date drilling completed: 11/20/2007

State Well Report
Part 1 – Driller's Log

Mississippi Department of Environmental Quality
 Office of Land and Water Resources
 P.O. Box 10631
 Jackson, MS 39289-0631
 (601)961-5210
 (601)354-6938 (fax)

For Office Use Only:

Aquifer: _____
 Well #: W-99
 L. S. Elevation: _____
 E-log #: _____

State Law requires that this report be prepared by the license holder responsible for the work and filed with the Department at the above address within 30 days of completion of drilling of the well or borehole.

Information on Well Owner (Landowner if borehole is not for a water well)	Well or Borehole Location
Owner Name <u>Fleet Morris Petroleum</u>	Latitude: <u>32 ° 24 ' 10 "</u> Longitude: <u>90 ° 06 ' 29 "</u>
Mailing Address: <u>PO Box 2347</u>	Method of Lat/Long (circle one): Conventional Survey,
<u>Madison MS 39130</u>	<input checked="" type="checkbox"/> <u>USGS quad</u> Hand-held GPS, Survey-grade GPS <input checked="" type="checkbox"/>
City State Zip Code	SE <u>1/4</u> NE <u>1/4</u> Sec <u>32</u> <input checked="" type="checkbox"/> Twn <u>7N</u> <input checked="" type="checkbox"/> Rng <u>2E</u>
Telephone No. (601) <u>898-3830</u>	Distance <u>2</u> Miles <u>SE</u> Direction of Nearest Town <u>Ridgeland</u>

Well / Borehole Data

Date drilling started: 11/19/07 Date drilling completed: 11/20/07 Hole depth: 24' Hole diameter: 12"

Location of the source of any surface water used for drilling: N/A

Method of dosing and volume of Chlorine used in drilling and development: N/A

Logs run (circle all applicable): No log run Electric Gamma Ray Density Sonic Neutron Other: _____

Name of organization running log(s): _____

Purpose of borehole (check one): Water Well ___ Geotechnical/Geological Investigation ___ Ground Source Heat Pump ___
 Seismic Survey ___ Other (describe) ___ Recovery well ___

If drilling is not related to water well construction, skip the remainder of this block

Purpose of Well (check one): Home ___ Industrial ___ Public Supply ___ Irrigation ___ Fish Culture ___ Other: Recovery

If a flowing well, method of flow regulation: Valve N/A Other (describe) _____

Static Water Level: N/A feet above or below (circle one) land surface Date measured: N/A

Method of Measurement (circle one) steel tape electric tape air line other: _____

Well depth: 24' Well grouted to a depth of 1 feet Type of grout (circle one): Neat Cement Bentonite Mix

Casing length: 4 feet Casing diameter: 4 inches Type of casing: PVC

Screen length: 20 feet Screen diameter: 4 inches Type of screen: PVC

Screen slot size: .010 inches Setting depth: From 4 feet to 24 feet


Type of completion (circle all applicable): Gravel packed Underreamed Telescoped Open hole Natural Development
 Other (describe): 2'x 2' well vault set in concrete pad

Top of lap pipe or reduction in casing: _____ feet. ***If telescoped or more than one screen, describe on next page***

W-99

The sketch below only required for water wells

If well telescopes, show depths on sketch.

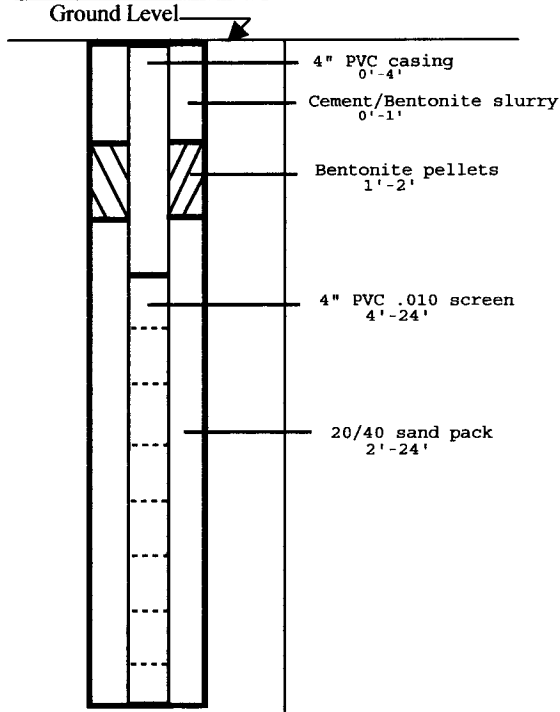


Description of formations encountered must be provided for all wells and boreholes, unless specifically exempted by regulations

Description of Formations Encountered	From (depth)	To (depth)
Lt. brown silty clay	Ground Level	24'

If more than one screen, show location of each on sketch

Sketch the property layout and include the following: 1) the well location; 2) any permanent structures on the property that may aid in locating the well; 3) any roads, power lines, or other items that may aid in locating the property and the well; 4) a north arrow.

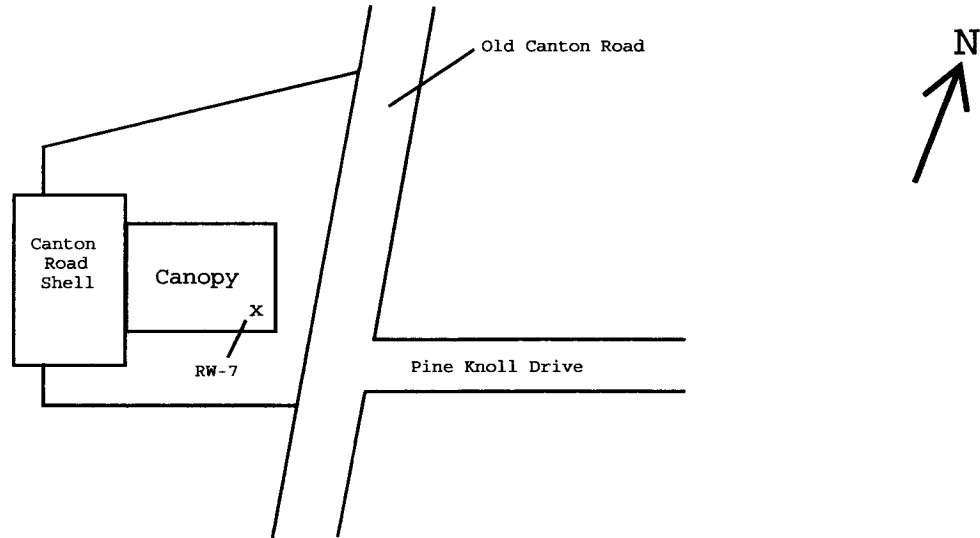

Landowner Name: Fleet Morris Petroleum - RW-7

Form: OLWR-SWR-1A

I certify that the well/borehole was drilled, constructed, and completed in accordance with all applicable requirements of the Mississippi Department of Environmental Quality and the Mississippi Department of Health regulations, if applicable, and state laws.

Print Name of Responsible Licensee and License No. GARY P. Hill 0-578 Date 12-27-07

Signature of Licensee Gary P Hill