

MISSISSIPPI

BOARD OF WATER COMMISSIONERS

416 North State Street

Jackson, Mississippi 39201

CODBD

Marion
A 1

WATER WELL DRILLERS LOG

TOM GRIFFITH

PLUMBING & WELL SERVICE, INC.

Marion

11/11/83

date well completed

320 MAYSON AVE.
COLUMBIA, MS 39428

county well located

LANDOWNER: M.D. Buchanan

description of formations encountered

from to

R.L.S

Fordworth, MS 39448
(mailing address)

Red Sand
Clay & Gravel
Real Gravel
Clay

1' 30'
20' 80'
30' 175'
175' 80'

WELL LOCATION:

sec. 32 T 5 N R 12 E
S W

10 miles N of Fordworth
(distance) (direction) (nearest town)

WELL PURPOSE: Home
(home, irrigation, municipal, industrial)

WELL COMPLETION DATA:

- (1) diameter (inches) 4"
- (2) total depth (feet) 175'
- (3) static water level (feet) _____ below above top of ground.
- (4) casing PVC 155' (material) (depth)
4" (size) if telescope see back.
- (5) screen 20' 155' (length) (depth to top)
4" PVC (size) (material)
- (6) pump 1 10 (HP) (yield gpm)
Elec. (type power)
- (7) electric log N/A (yes or no)
N/A (organization running log)
- (8) how well bottom plugged BCWV

DEPT. OF NATURAL RESOURCES
BUREAU OF LAND & WATER RESOURCES


FEB 16 1984

RECEIVED

DRILLERS REMARKS:

If well telescopes please sketch and show depths.

GROUND LEVEL

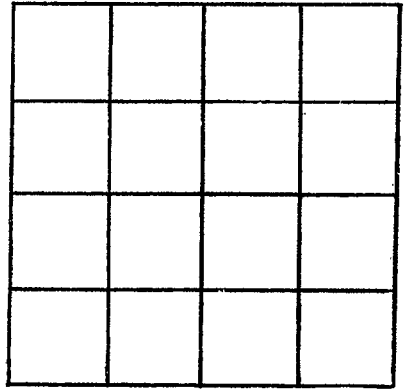

SECTION _____

Please indicate well location X.

ADDITIONAL INFORMATION

If more than one screen, show locations of each on sketch.