

MISSISSIPPI DEPARTMENT OF NATURAL RESOURCES

Bureau of Land and Water Resources

Southport Mall

P.O. Box 10631

Jackson, Mississippi 39209

WATER WELL DRILLERS LOG

Marion
A 2

copy

DODD

7-18 1986
 date well completed

Hollinger
 firm name

Marion
 county well located

LANDOWNER: DR Tom WATTS
Hw 13 N
Columbia, MS
 (mailing address)

description of formations encountered	from	to
<u>Chalk</u>	<u>0</u>	<u>20</u>
<u>SAND, GRAVEL</u>	<u>20</u>	<u>47</u>

WELL LOCATION:
 sec. 19 T. 5 (N) R. 20 E
8 miles NW of BOSS
 (distance) (direction) (nearest town)

WELL PURPOSE: Crop
 (home, irrigation, municipal, industrial)

WELL COMPLETION DATA:

(1) diameter (inches) 2"

(2) total depth (feet) 47

(3) static water level (feet) 10 below top of ground.

(4) casing pvc 47
 (material) (depth)

_____ if telescope see back.
 (size)

(5) screen 1/2 37
 (length) (depth to top)

2 pvc
 (size) (material)

(6) pump 1/3 6
 (HP) (yield gpm)

elect
 (type power)

(7) electric log _____
 (yes or no)


_____ (organization running log)

(8) how well bottom plugged SAND
SHARK

DRILLERS REMARKS: Very Good
Well

If well telescopes please sketch and show depths.

GROUND LEVEL

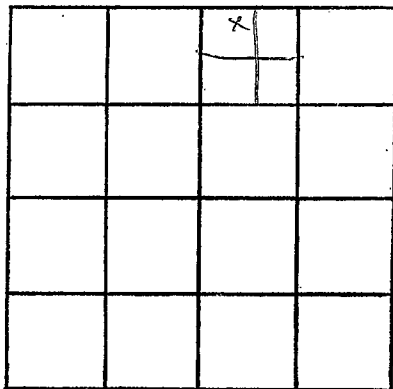

SECTION 9

Please indicate well location X.

ADDITIONAL INFORMATION

If more than one screen,
show locations of each on sketch.