

Marion
 A 3
 8/4/77

MISSISSIPPI
 BOARD OF WATER COMMISSIONERS
 416 North State Street
 Jackson, Mississippi 39201

(98)

CODD

WATER WELL DRILLERS LOG

aug 4 19 77 Reussmiller marion
 date well completed firm name county well located

LANDOWNER:
Orea Dennis
Rt 1 Foywath
 (mailing address)
 WELL LOCATION:
 sec. 21 T 5 N R M E
11 miles N-NW of Foywath
 (distance) (direction) (nearest town)

description of formations encountered	from	to
Red Sandy Clay		
<u>Red Sandy Clay</u>	<u>0</u>	<u>22</u>
<u>2nd Sand</u>	<u>29</u>	<u>70</u>
<u>big gravel & sand</u>	<u>70</u>	<u>150</u>
<u>10 pea gravel & sand</u>	<u>150</u>	<u>166</u>

WELL PURPOSE: home
 (home, irrigation, municipal, industrial)

WELL COMPLETION DATA:
 (1) diameter (inches) 4
 (2) total depth (feet) 166
 (3) static water level (feet) 130 below above top of ground.
 (4) casing 4" bottom
 (material) (depth)
 (size) if telescope see back.
 (5) screen 6" 160
 (length) (depth to top)
4" plastic
 (size) (material)
 (6) pump 1/2 hp 10
 (HP) (yield gpm)
slat
 (type power)
 (7) electric log no
 (yes or no)
 (organization running log)


(8) how well bottom plugged:
wooden plug
 DRILLERS REMARKS:

RECEIVED
 DEC 30 1977

MISS. BD. OF WATER COMM

If well telescopes please sketch and show depths.

GROUND LEVEL

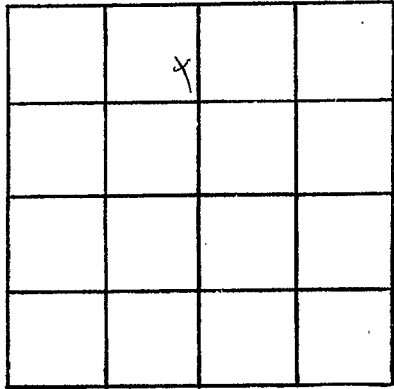

SECTION 22

Please indicate well location X.

ADDITIONAL INFORMATION

If more than one screen, show locations of each on sketch.