

Marion
 A U
 6-19-79

MISSISSIPPI
 BOARD OF WATER COMMISSIONERS
 416 North State Street
 Jackson, Mississippi 39201

CODED

WATER WELL DRILLERS LOG

Marion

June 19, 1979 Reeves Well Service Sertima
 date well completed firm name county well located

LANDOWNER:
 Alton Thornhill
 Rt Foxworth
 (mailing address)

description of formations encountered	from	to
Red Clay	0	18
Red sand	18	60
Chalk & sand	60	105
fine pink sand	105	145
sand & gravel	145	160

WELL LOCATION:
 sec 34 T. 4 N. R. 12 E
 5 miles E-SE of Sertima
 (distance) (direction) (nearest town)

WELL PURPOSE: Home
 (home, irrigation, municipal, industrial)

WELL COMPLETION DATA:

(1) diameter (inches) 4"

(2) total depth (feet) 160

(3) static water level (feet) 120 below top of ground

(4) casing plastic (material), bottom (depth)
 (size) if telescope see back.

(5) screen 3' (length), 155' (depth to top)
4" (size), plastic (material)

(6) pump 3 hp (HP), 12 (yield gpm)
split (type power)

(7) electric log no (yes or no)

(organization running log)

(8) how well bottom plugged
Wooden plug


DRILLERS REMARKS:

DEPT. OF NATURAL RESOURCES
 BUREAU OF LAND & WATER RESOURCES

JAN 22 1980
 RECEIVED

If well telescopes please sketch and show depths.

GROUND LEVEL

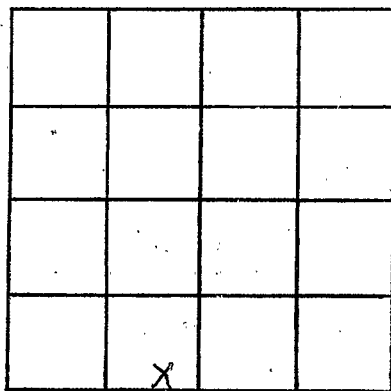

SECTION 34

Please indicate well location X.

ADDITIONAL INFORMATION

If more than one screen,
show locations of each on sketch.