

MARION  
 A5  
 6-3-77

MISSISSIPPI  
 BOARD OF WATER COMMISSIONERS  
 416 North State Street  
 Jackson, Mississippi 39201

60

CABD

WATER WELL DRILLERS LOG

MARION  
 Lawrence

June 3 1977 date well completed  
 Rumer Well firm name  
 Marion Lawrence county well located

LANDOWNER:  
 W. H. Mc Kenzie  
 Rt 2 Monticello  
 (mailing address)

description of formations encountered	from	to
Clay	0	7.5
Red sand gravel	7.5	8.0
White Chalk	8.0	11.0
lime Chalk sand	11.0	16.0
Coarse white sand	16.0	20.3

WELL LOCATION:  
 sec. 23 T. 5 N R. 12 E  
 12 miles S-SE of Monticello  
 (distance) (direction) (nearest town)

WELL PURPOSE: Home  
 (home, irrigation, municipal, industrial)

WELL COMPLETION DATA:

(1) diameter (inches) 4"

(2) total depth (feet) 202

(3) static water level (feet) 1.50 below top of ground.

(4) casing plastic bottom  
 (material) (depth)

(size) if telescope see back.

(5) screen 10' 192  
 (length) (depth to top)

4" plastic  
 (size) (material)

(6) pump 3 12  
 (HP) (yield gpm)

Electric  
 (type power)

(7) electric log no  
 (yes or no)

(organization running log)


(8) how well bottom plugged  
 Wooden plug

DRILLERS REMARKS:

RECEIVED  
 AUG 26 1977

If well telescopes please sketch and show depths.

GROUND LEVEL

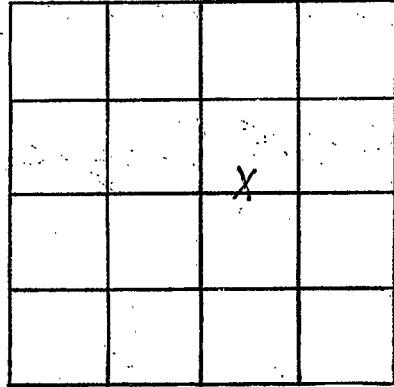

SECTION 23

Please indicate well location X.

ADDITIONAL INFORMATION

If more than one screen,  
show locations of each on sketch.