

MISSISSIPPI
BOARD OF WATER COMMISSIONERS
416 North State Street
Jackson, Mississippi 39201

WATER WELL DRILLERS LOG

Marion
A 2000
12/2/76

13V

Dec 2 1976 Reeves Well Dr Marion
date well completed firm name county well located

LANDOWNER:
Billy Smith
RT 1 Foxworth Miss
(mailing address)

description of formations encountered	from	to
<u>Clay gravel</u>	<u>0</u>	<u>12</u>
<u>loamy sand</u>	<u>12</u>	<u>30</u>
<u>Chalk sand</u>	<u>30</u>	<u>75</u>
<u>sand & fine gravel</u>	<u>75</u>	<u>91</u>

WELL LOCATION:
sec. 34 T. 5 N R. 12 E
1 miles South of White Bluff
(distance) (direction) (nearest town)

WELL PURPOSE: home
(home, irrigation, municipal, industrial)

WELL COMPLETION DATA:

(1) diameter (inches) 4"

(2) total depth (feet) 91

(3) static water level (feet) 65 below top of ground.

(4) casing plastic, bottom
(material) (depth)

— if telescope see back.
(size)

(5) screen 6", 85'
(length) (depth to top)

4", plastic
(size) (material)

(6) pump Sub, 10
(HP) (yield gpm)

elect
(type power)

(7) electric log no
(yes or no)


—
(organization running log)

(8) how well bottom plugged
Wooden Plug

DRILLERS REMARKS:
—

If well telescopes please sketch and show depths.

GROUND LEVEL

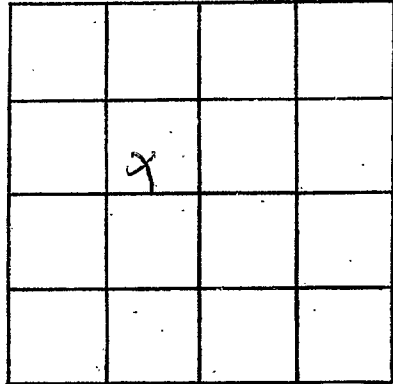

SECTION 34

Please indicate well location X.

ADDITIONAL INFORMATION

If more than one screen,
show locations of each on sketch.