

**MISSISSIPPI DEPARTMENT OF NATURAL RESOURCES**  
**Bureau of Land and Water Resources**  
 Southport Mall  
 P.O. Box 10631  
 Jackson, Mississippi 39209  
**WATER WELL DRILLERS LOG**

MARION  
A 2003

4-22 1995 Hollinger Well Service MARION  
 date well completed firm name county well located

LANDOWNER: Tim KYZAR  
P.O. Box 367  
Columbia, Ms 39429  
 (mailing address)

description of formations encountered	from	to
	<u>Red Clay sand</u>	<u>0</u>
<u>Chalk</u>	<u>30</u>	<u>230</u>
<u>sand</u>	<u>230</u>	<u>260</u>

WELL LOCATION:  
 sec 31 T 5 (N) R 2 (E)  
7 miles W of Cross  
 (distance) (direction) (nearest town)

WELL PURPOSE: Camp  
 (home, irrigation, municipal, industrial)

WELL COMPLETION DATA:

- (1) diameter (inches) 4"
- (2) total depth (feet) 260
- (3) static water level (feet) 10  below  above top of ground.
- (4) casing pvc 250  
 (material) (depth)  
 (size) if telescope see back.
- (5) screen 10 250  
 (length) (depth to top)  
4 pvc  
 (size) (material)
- (6) pump 1/2 10  
 (HP) (yield gpm)  
elect  
 (type power)
- (7) electric log \_\_\_\_\_  
 (yes or no)

\_\_\_\_\_  
 (organization running log)

(8) how well bottom plugged sand  
shark

DRILLERS REMARKS: Very Good  
Well


**RECEIVED**

JUN 21 1995

Dept. of Environmental Quality  
 Office of Land & Water Resources

If well telescopes please sketch and show depths.

GROUND LEVEL

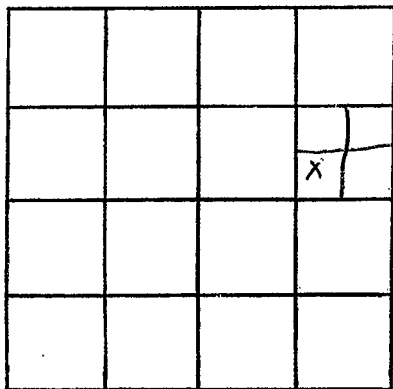

SECTION 31

Please indicate well location X.

ADDITIONAL INFORMATION

If more than one screen,  
show locations of each on sketch.