

MARION

MISSISSIPPI BOARD OF WATER COMMISSIONERS

B9

6-17-66

WATER WELL DRILLERS LOG

CODED

Date: 6-17, 1966, Driller: E. B. SHERRARD County: MARION

(Name)

(1) Owner of Land: M. D. Cooper
 (Name)
Rt. 4 - Columbia
 (Address)

(2) Location: _____ 1/4, _____ 1/4, Sec. 22 T. 5 N. R. 19 W.
2 1/2 miles N., of Goss
 (distance) (direction) (Nearest Town)

(3) Topography: (Hilly) _____ (Flat) _____ (Level)

(4) Purpose of Well: DOMESTIC
 (Domestic Irrigation
 Municipal, Industrial, Other)

Description & Color of Materials Sand, Clay, Red Clay, Shell, etc.	Thick- ness Feet	Dep Fe
<u>RED SANDY CLAY</u>	<u>20</u>	
<u>SAND & GRAVEL</u>	<u>80</u>	

Information upon completion of well:

(1) Diameter 2 inches.

(2) Total Depth 80 feet.

(3) Water Level 54' feet below top of ground.

(4) Cased to 80', Size 2"


(5) Screen: Size 2", Length 3'

(6) Were any formations sealed against pollution?
 _____ yes, no.

If YES depth of formation _____

Why _____

Drillers Remarks: _____

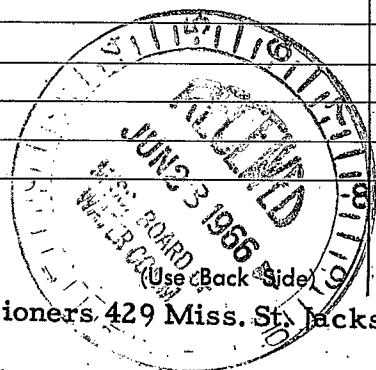

Well No.

[Faint, illegible text covering the majority of the page]

[Faint, illegible text in the lower-left quadrant]