

check in-logs

Marion
B 12
1-70
M65
JAN 1970

MISSISSIPPI
BOARD OF WATER COMMISSIONERS
416 North State Street
Jackson, Mississippi 39201

WATER WELL DRILLERS LOG

1970 Griner Drilling Service, Inc Marion
firm name county well located

LANDOWNER: Georgia-Pacific
Gross, Miss
(mailing address)

description of formations encountered	from	to
Top Soil	0	2
Clay	2	14
Sand & Gravel	14	280
Clay	280	285

WELL LOCATION:
sec 35 T 5N R 19W
S W
7 miles N of Columbia
(distance) (direction) (nearest town)

WELL PURPOSE: Industrial
(home, irrigation, municipal, industrial)

- WELL COMPLETION DATA:
- (1) diameter (inches) 16 X 10
 - (2) total depth (feet) 220'
 - (3) static water level (feet) 35' below top of ground.
 - (4) casing Steel, 170'
(material) (depth)
16" if telescope see back.
(size)
 - (5) screen 40', 180'
(length) (depth to top)
10", 3.5.
(size) (material)
 - (6) pump 50 700
(HP) (yield gpm)
Electric
(type power)
 - (7) electric log yes
(yes or no)
MFS
(organization running log)
 - (8) how well bottom plugged Back
WASH VALVE

COPIED

JAN 23 1970


DRILLERS REMARKS:

MISS. BD. OF
WATER COMM.

②

If well telescopes please sketch and show depths.

GROUND LEVEL

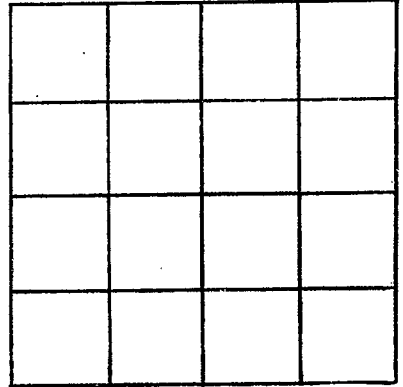

SECTION _____

Please indicate well location X.

ADDITIONAL INFORMATION

If more than one screen, show locations of each on sketch.