

Marion

B 13

12-15-69

MISSISSIPPI  
 BOARD OF WATER COMMISSIONERS  
 416 North State Street  
 Jackson, Mississippi 39201

**CODED**

WATER WELL DRILLERS LOG

12/15

1969

Dean Drines

Marion

date well completed

firm name

county well located

LANDOWNER:

Mr. R. D. McNeese  
 Route 4, Columbia, Miss.  
 (mailing address)

description of formations encountered

from to

Top soil 0-1'  
 red clay 1'-24'  
 Chalk 24'-60'  
 fine sand 60'-85'  
 coarse water sand 85'-108'

WELL LOCATION:

sec. 22 T. 5 N R. 19 E S 12  
 (distance) miles (direction) of Columbia (nearest town)

WELL PURPOSE: Home Use (home, irrigation, municipal, industrial)

WELL COMPLETION DATA:

- (1) diameter (inches) 2"
- (2) total depth (feet) 108'
- (3) static water level (feet) \_\_\_\_\_ below/above top of ground.
- (4) casing Galv. Pipe 105' (material) (depth) (size) if telescope see back.
- (5) screen 5' 105' (length) (depth to top) 2" Galvanize (size) (material)
- (6) pump \_\_\_\_\_ (HP) \_\_\_\_\_ (yield gpm) Used old pump (type power)
- (7) electric log No (yes or no) (organization running log)
- (8) how well bottom plugged \_\_\_\_\_

**CODED**


MAR 18 1970

MISS. BD. OF WATER COMM.

DRILLERS REMARKS:

If well telescopes please sketch and show depths.

GROUND LEVEL

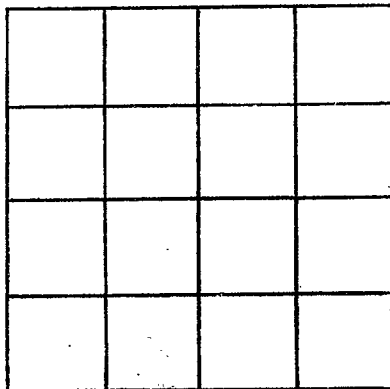

SECTION \_\_\_\_\_

Please indicate well location X.

ADDITIONAL INFORMATION

If more than one screen, show locations of each on sketch.