

MARION
B 14
10-4-71

MISSISSIPPI
BOARD OF WATER COMMISSIONERS
416 North State Street
Jackson, Mississippi 39201

FEB - 7 1972

WATER WELL DRILLERS LOG

CODED

10-4 1971 Dean Hieber Drilling Marion
date well completed firm name county well located

LANDOWNER:
Randy Barnes
Dale St. Columbia, Miss.
(mailing address)

description of formations encountered	from	to
topsoil	0	1'
clay	1	21'
chalk	21	47'
gravel + sand	47	59'
fine sand	59	98'
Water sand	91	120'

WELL LOCATION:
sec. 25 T. 5 S. R. 20 E. W. 2
15 miles N.W. of Columbia
(distance) (direction) (nearest town)

WELL PURPOSE: Camp
(home, irrigation, municipal, industrial)


- WELL COMPLETION DATA:
- (1) diameter (inches) 2"
 - (2) total depth (feet) 120'
 - (3) static water level (feet) 20' below top of ground.
 - (4) casing Plastic, 111' (material) (depth)
If telescope see back.
(size)
 - (5) screen 7' 113' (length) (depth to top)
2" Plastic (size) (material)
 - (6) pump Used old (HP) pump (yield gpm)
(type power)
 - (7) electric log (yes or no)
(organization running log)
 - (8) how well bottom plugged

CODED

DRILLERS REMARKS:

If well telescopes please sketch and show depths.

GROUND LEVEL

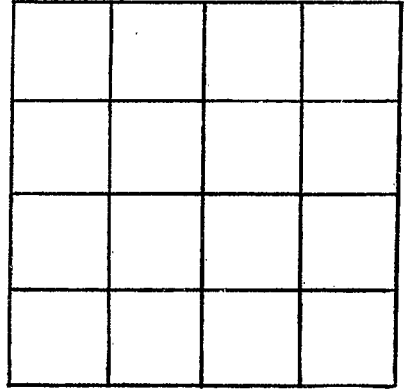

SECTION _____

Please indicate well location X.

ADDITIONAL INFORMATION

If more than one screen, show locations of each on sketch.