

MARION  
B15  
4-24-72

MISSISSIPPI  
BOARD OF WATER COMMISSIONERS  
416 North State Street  
Jackson, Mississippi 39201  
WATER WELL DRILLERS LOG

**CODEN**

4-24-1972 PRENTISS BUTANE MARION  
date well completed firm name county well located

LANDOWNER:	description of formations encountered	from	to
J. W. CASEY	SAND	0	32
DAKVALE (mailing address)			
<b>WELL LOCATION:</b>			
sec 20 T 5 N R 19 E S W			
10 miles NW of COLUMBIA (distance) (direction) (nearest town)			
<b>WELL PURPOSE:</b> (home, irrigation, municipal, industrial)			
<b>WELL COMPLETION DATA:</b>			
(1) diameter (inches) 2			
(2) total depth (feet) 32			
(3) static water level (feet) _____ below above top of ground.			
(4) casing _____ (material) ' (depth) ' _____ If telescope see back. (size)			
(5) screen _____ (length) ' (depth to top) _____ (size) ' (material)			
(6) pump 1/3 540 (HP) (yield gpm)			
E (type power)			
(7) electric log (yes or no) _____			
_____ (organization running log)			
(8) how well bottom plugged B.W.V			
<b>DRILLERS REMARKS:</b>			


**CODEN**

MAY 15 1972

MISS. RD. DEPT.  
WATER BUREAU

If well telescopes please sketch and show depths.

GROUND LEVEL

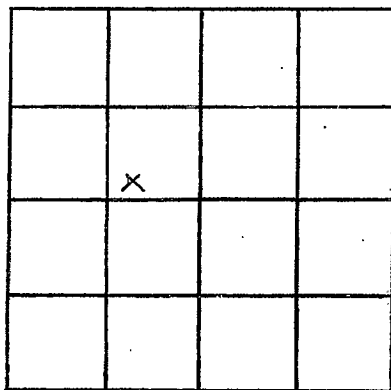

SECTION 20

Please indicate well location X.

ADDITIONAL INFORMATION

If more than one screen,  
show locations of each on sketch.