

MARION
B 16
9-22-73

MISSISSIPPI
BOARD OF WATER COMMISSIONERS
416 North State Street
Jackson, Mississippi 39201

CODED

WATER WELL DRILLERS LOG

9/22/73
date well completed

Griner-Gunn
firm name

Marion
county well located

LANDOWNER: Randolph Davis
Meadowcroft
Columbia Miss
(mailing address)

description of formations encountered	from	to
Top Soil	0	1
Clay	1	6
Sand	6	30

WELL LOCATION:
sec. 19 T 5 N R. 19 E
12 miles NW of Columbia
(distance) (direction) (nearest town)

WELL PURPOSE: Home
(home, irrigation, municipal, industrial)

- WELL COMPLETION DATA:
- (1) diameter (inches) 2"
 - (2) total depth (feet) 30'
 - (3) static water level (feet) 17 below top of ground.
 - (4) casing Plastic, 25'
(material) (depth)
2" if telescope see back.
(size)
 - (5) screen 7', 23'
(length) (depth to top)
2", Plastic
(size) (material)
 - (6) pump 1 1/2 6
(HP) (yield gpm)
Elec
(type power)
 - (7) electric log _____
(yes or no)

(organization running log)
 - (8) how well bottom plugged BW Valve


CODED

DRILLERS REMARKS:

OCT 9 1973

If well telescopes please sketch and show depths.

GROUND LEVEL

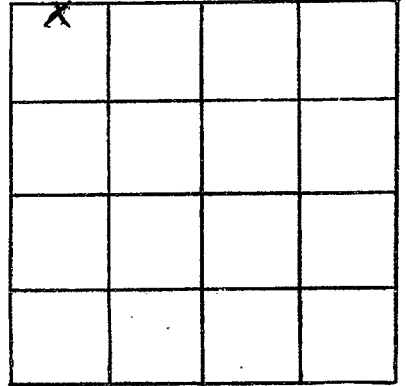

SECTION 19

Please indicate well location X.

ADDITIONAL INFORMATION

If more than one screen,
show locations of each on sketch.