

MARION  
B17  
9/73

MISSISSIPPI  
BOARD OF WATER COMMISSIONERS CODED  
416 North State Street  
Jackson, Mississippi 39201

WATER WELL DRILLERS LOG

Sept. 23 1973 E.B. Sheward Marion  
date well completed firm name county well located

LANDOWNER:  
G.L. Stephens  
Pt 4 - Columbia, Miss.  
(mailing address)

description of formations encountered	from	to
LOOSE SANDY CLAY	0	50'
FINE SAND	50	90'
COARSE SAND & GRAVEL	90	139'

WELL LOCATION:  
Sec 26 T. 5 N R. 19 E  
8 miles N of Columbia  
(distance) (direction) (nearest town)

WELL PURPOSE:  
(home, irrigation, municipal, industrial)

CODED

WELL COMPLETION DATA:

(1) diameter (inches) 2"

(2) total depth (feet) 139'

(3) static water level (feet) 55' <sup>below</sup> top of ground

(4) casing pl. 134'  
(material) (depth)  
2" if telescope see back.  
(size)

(5) screen 5'  
(length) (depth to top)  
2" pl.  
(size) (material)


(6) pump 1 8  
(HP) (yield gpm)  
E  
(type power)

(7) electric log (yes or no)

(organization running log)


(8) how well bottom plugged BWV

DRILLERS REMARKS:

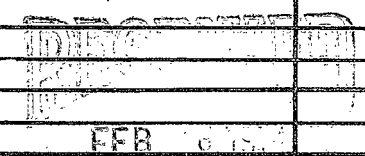

If well telescopes please sketch and show depths.

GROUND LEVEL

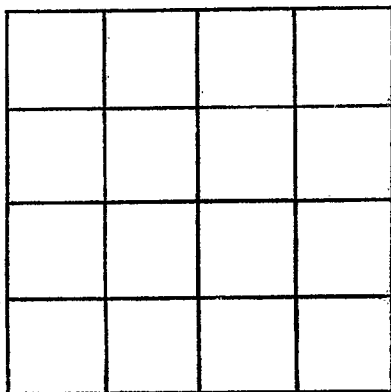

SECTION \_\_\_\_\_

Please indicate well location X.

ADDITIONAL INFORMATION

If more than one screen, show locations of each on sketch.