

MARION
B 18
9/23

MISSISSIPPI
BOARD OF WATER COMMISSIONERS
416 North State Street
Jackson, Mississippi 39201

CODED

WATER WELL DRILLERS LOG


Sept. 1973 E. B. Sherrad Marion
date well completed firm name county well located

LANDOWNER:	description of formations encountered	from	to
Chaney Rogers Rt. 4 - Columbia (mailing address)	SANDY CLAY CLAY STREAKS + SAND CLAY GRAY LOOSE PEACH + COARSE SAND	0 25 45 65 90	25 45 65 90
WELL LOCATION: sec. 34 T 5 N R 19 E 7 miles N of Columbia (distance) (direction) (nearest town)			
WELL PURPOSE: Commercial Home, irrigation, municipal, industrial			
WELL COMPLETION DATA: (1) diameter (inches) 4" (2) total depth (feet) 92' (3) static water level (feet) 40' ^{below} above top of ground. (4) casing pl. 82' (material) (depth) 4" if telescope see back. (size) (5) screen 10' (length) (depth to top) 4" pl. (size) (material) (6) pump 1-pub. 30 (HP) (yield gpm) E (type power) (7) electric log (yes or no) <input checked="" type="radio"/> (organization running log) (8) how well bottom plugged BWV			
DRILLERS REMARKS:	FFR		

CODED

If well telescopes please sketch and show depths.

GROUND LEVEL

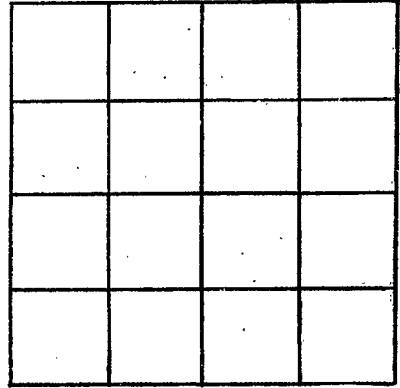

SECTION _____

Please indicate well location X.

ADDITIONAL INFORMATION

If more than one screen, show locations of each on sketch.