

MARION
B20
12-6-73

MISSISSIPPI
 BOARD OF WATER COMMISSIONERS
 416 North State Street
 Jackson, Mississippi 39201

CODED

WATER WELL DRILLERS LOG
 GRINER - GINN

Marion
 county well located

12-6 19*73*
 date well completed

firm name

LANDOWNER:
Mrs. Janice Prine
Rt. 4 Columbia Miss
 (mailing address)

description of fomations encountered	from	to
<i>Top Soil</i>	<i>0</i>	<i>2</i>
<i>Clay</i>	<i>2</i>	<i>21</i>
<i>Sand</i>	<i>21</i>	<i>29</i>
<i>Clay</i>	<i>29</i>	<i>38</i>
<i>Sand</i>	<i>38</i>	<i>55</i>

WELL LOCATION:
 sec *23* T *5* R *19*
17 miles *N* of *Columbia*
 (distance) (direction) (nearest town)

WELL PURPOSE: *Home*
 (home, irrigation, municipal, industrial)

- WELL COMPLETION DATA:
- (1) diameter (inches) *4"*
 - (2) total depth (feet) *55*
 - (3) static water level (feet) *21* below above top of ground.
 - (4) casing *plastic*, *45*,
 (material) (depth)
4"
 (size) if telescope see back.
 - (5) screen *10'*, *45*
 (length) (depth to top)
4", *plastic*
 (size) (material)
 - (6) pump *1/3*, *5*
 (HP) (yield gpm)
elec.
 (type power)
 - (7) electric log *NO*
 (yes or no)
NO
 (organization running log)
 - (8) how well bottom plugged
B.W. Valve


CODED

DRILLERS REMARKS:

INDEXED
 FILED
 MAY 28 1974
 MISS. Bd. OF WATER COMMISSIONERS

If well telescopes please sketch and show depths.

GROUND LEVEL

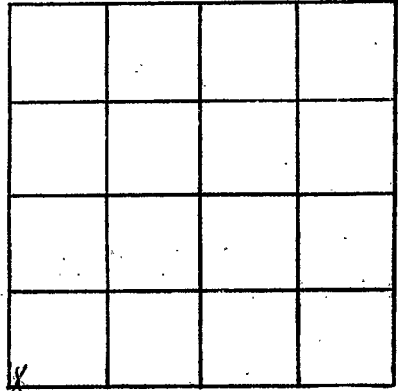

SECTION 23

Please indicate well location X.

ADDITIONAL INFORMATION

If more than one screen, show locations of each on sketch.