

MARION
B 21
12-20-73

MISSISSIPPI
BOARD OF WATER COMMISSIONERS
416 North State Street
Jackson, Mississippi 39201

CODED

WATER WELL DRILLERS LOG

12-20 1973
date well completed

GRINER - GINN
firm name

Marion
county well located

LANDOWNER:
R. D. McNeese
Rt. 4 Columbia, Miss.
(mailing address)

description of formations encountered	from	to
Top Soil	0	2
Clay	2	12
Sand	12	41
Chalk	41	79
Sand	79	100

WELL LOCATION:
sec 22 T 5 S R 19 E
13 miles N of Columbia
(distance) (direction) (nearest town)

WELL PURPOSE: Home
(home, irrigation, municipal, industrial)

- WELL COMPLETION DATA:
- (1) diameter (inches) 2"
 - (2) total depth (feet) 100
 - (3) static water level (feet) 70 below above top of ground.
 - (4) casing plastic, 90,
(material) (depth)
2" if telescope see back.
(size)
 - (5) screen 10', 90
(length) (depth to top)
 - 2", plastic
(size) (material)
 - (6) pump 3/4, 9
(HP) (yield gpm)
 - (type power)
 - (7) electric log NO
(yes or no)
 - NO
(organization running log)
 - (8) how well bottom plugged
B.W. Valve


CODED

DRILLERS REMARKS:

MAY 23 1974
MISS. Bd. OF WATER COMMISSIONERS

If well telescopes please sketch and show depths.

GROUND LEVEL

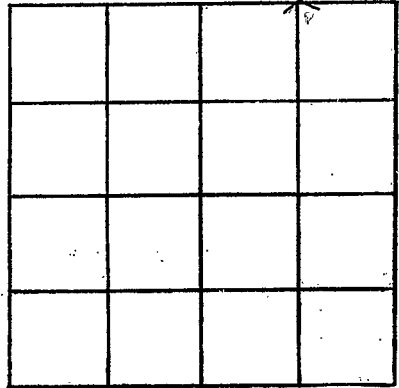

SECTION 22

Please indicate well location X.

ADDITIONAL INFORMATION

If more than one screen,
show locations of each on sketch.