

Marion
 B 22
 1175

MISSISSIPPI
 BOARD OF WATER COMMISSIONERS
 416 North State Street
 Jackson, Mississippi 39201

CODED

WATER WELL DRILLERS LOG

JAN. 1975 E. B. SHERRARD MARION
 date well completed firm name county well located

LANDOWNER:
 ROBERT TURNAGE
 Rt. 4 Columbia, Ms.
 (mailing address)

| description of formations encountered | from | to |
|---------------------------------------|------|-----|
| RED SANDY CLAY | 0 | 40' |
| GRAVEL & SAND | 40' | 92' |

WELL LOCATION:
 sec 23 T 5 N R 19 E
 9 miles NW of Columbia
 (distance) (direction) (nearest town)

WELL PURPOSE:
 (home, irrigation, municipal, industrial)

- WELL COMPLETION DATA:
- (1) diameter (inches) 2"
 - (2) total depth (feet) 82'
 - (3) static water level (feet) 50' ^{below} above top of ground.
 - (4) casing pl. 77' (material) (depth)
 2" if telescope see back. (size)
 - (5) screen 5' (length) (depth to top)
 2" (size) pl. (material)
 - (6) pump 1 (HP) 7 (yield gpm)
 e (type power)
 - (7) electric log (yes or no) (no)
 (organization running log)
 - (8) how well bottom plugged BWV


RECEIVED

MAY - 8 1975

DRILLERS REMARKS:

If well telescopes please sketch and show depths.

GROUND LEVEL

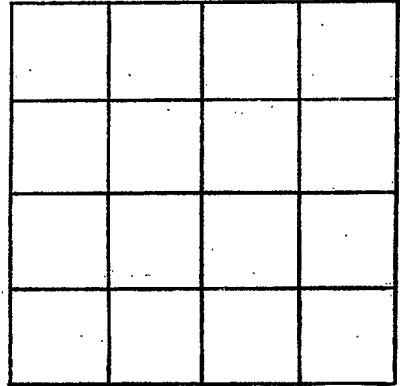

SECTION _____

Please indicate well location X.

ADDITIONAL INFORMATION

If more than one screen, show locations of each on sketch.